Name Samuel Brendler **Service No.** 49

Address #8 Turning Mill Rd Lot 3

8 Turning Mill Road **Location**

Kind of Pipe **Size** 6" **Size of Main** 8"

Repair—Renewal—New Service Craftsmen #580 **Location** JUL 24 1967

Date		Material	Amount		Total		Date			Amount	
1967	23'	6" Transite Pipe @ 7.00			161	00	5-1967		Deposit	161	00
5-31-67	110'	6" Transite pipe									
	5'	4" Cast Iron Pipe									
		2.3 @ 7									

J.B.M.18501

DATE _____

TOWN OF LEXINGTON — BOARD OF PUBLIC WORKS

SEWER DIVISION

Sketch of Service Here 8

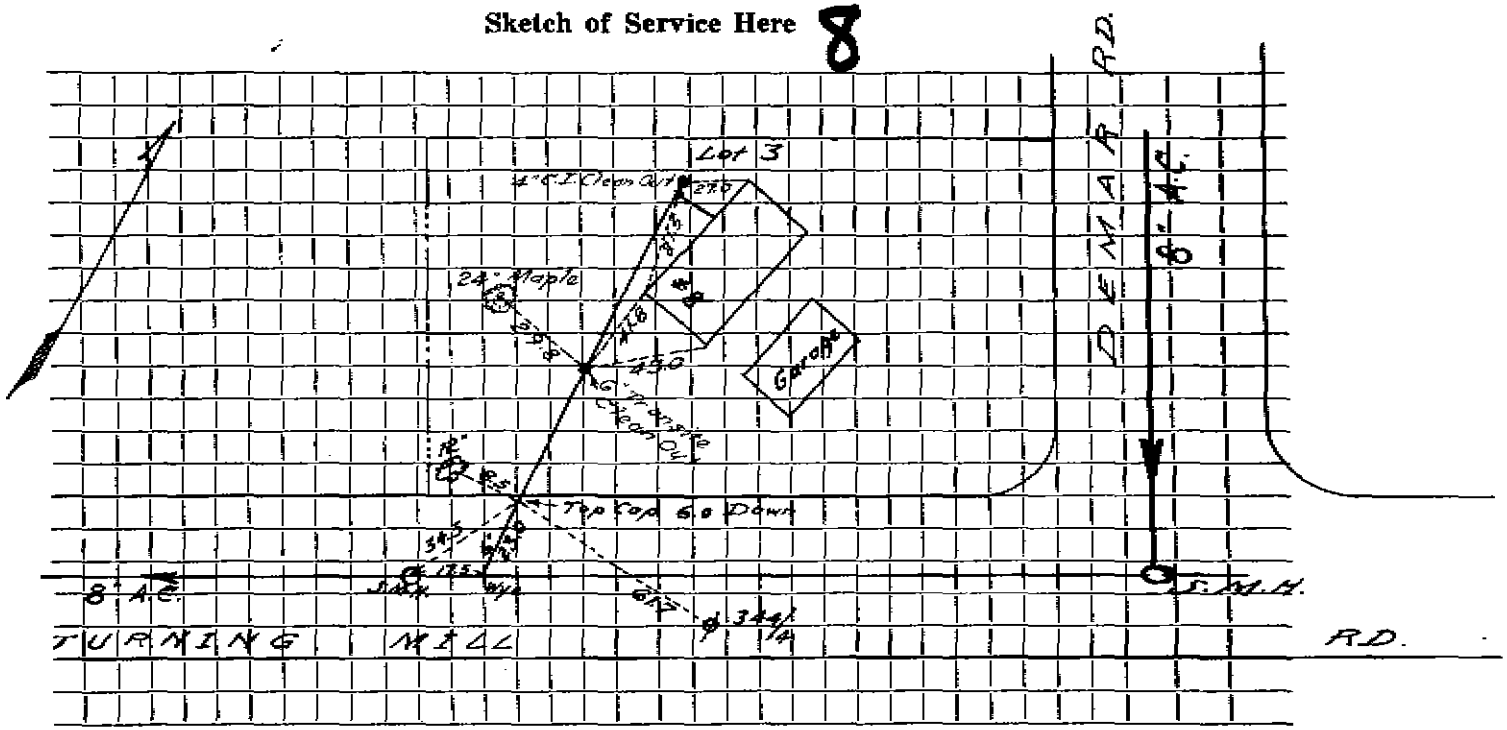

Connection made in ..... Street. Work completed .....

Remarks: .....

.....

.....