Name JAY FAKHARZADCH Service No.

Address 34 TYLER ROAD

Location

Kind of Pipe P.V.C. Size 6" Size of Main

Repair—Renewal—New Service PERMIT No 1069 Location

Date		Material	Amount		Total		Date			Amount	
MARCH 20	98	162' - 6" P.V.C									
"	"	2 - CLEANOUTS									
"	"	1 - 45° BEND									
"	"	1 - WYE									

DATE MARCH 20 1998

TOWN OF LEXINGTON — BOARD OF PUBLIC WORKS

SEWER DIVISION

Sketch of Service Here

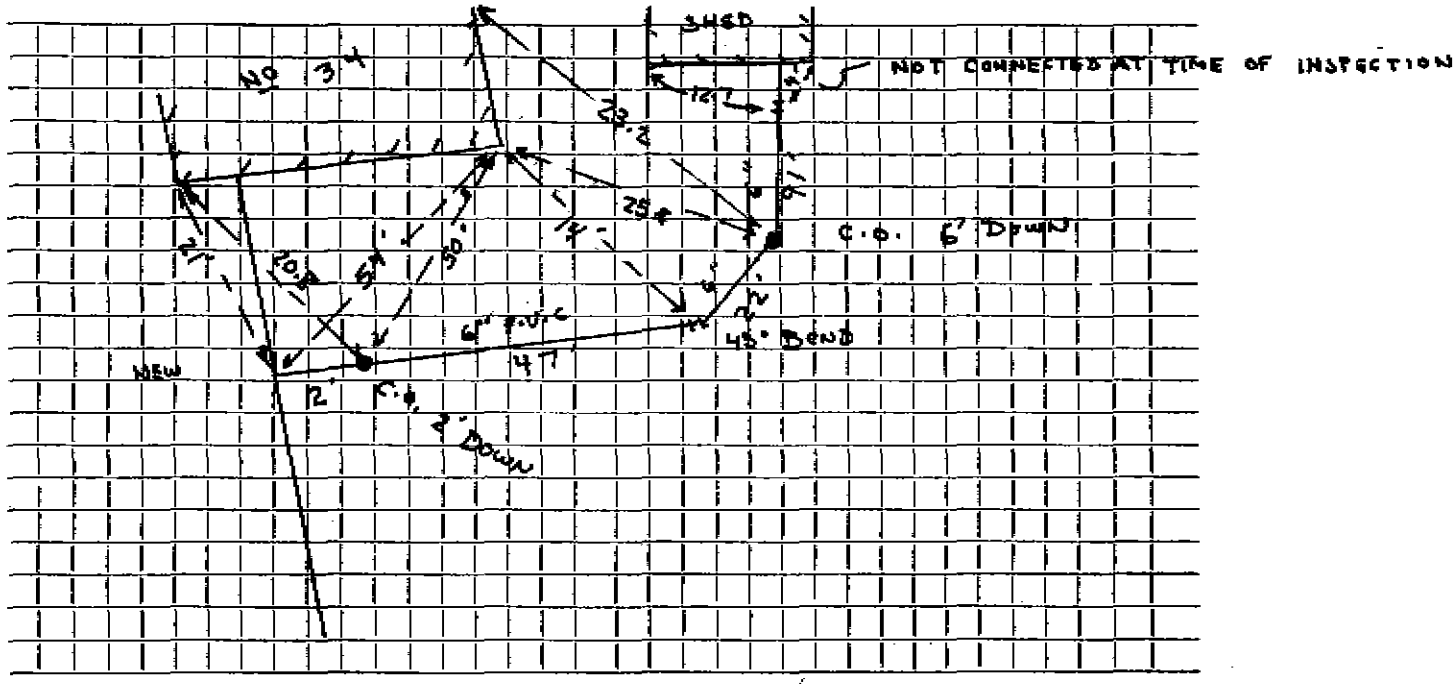

Connection made in TYLER ROAD Street. Work completed F. H. P. CONSTRUCTION

Remarks: CONNECTING NEW SHED TO EXISTING SEWER SVC

FIELD BOOK 98-1 TJM

Name

Service installed by developer

Service No.

Address #34 Tyler Road

34 Tyler Road

Location

Kind of Pipe

Size 6"

Size of Main 8"

Repair—Renewal—New Service

Location

Date	Material	Amount	Total	Date		Amount
	Labor					

HP-6411

TOWN OF LEXINGTON—DEPT. OF PUBLIC WORKS

SEWER DIVISION

DATE ..... NO. .....

The undersigned applies for the construction of a particular sewer connecting No. ..... Street and hereby agrees to comply with the Rules and Regulations governing the construction and use of Particular Sewers, as now or at any future time established by the Board of Selectmen.

Am't of estimate $.....

Am't Paid $.....

..... Owner

Sketch of Service Here

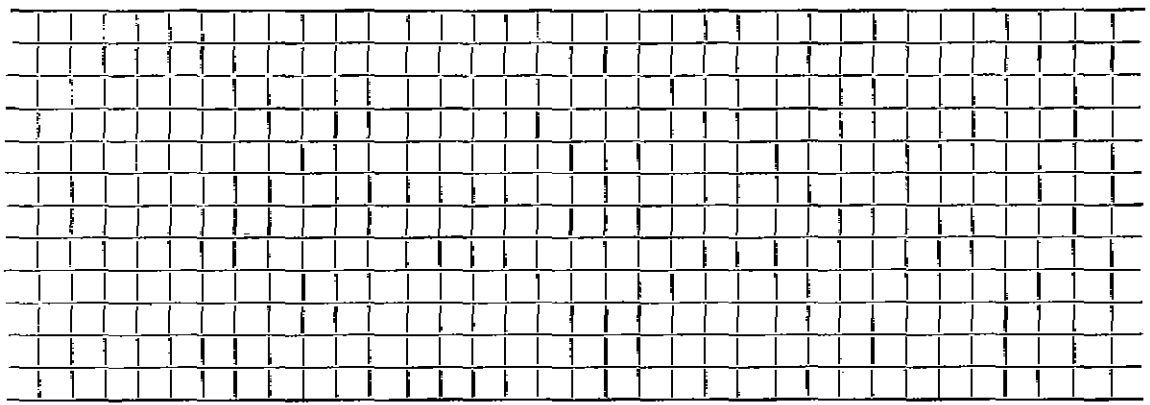

Connection made in ..... Street. Work completed ..... 19..

Remarks: