Name Susan Vernick Service No.

Address 32 VAILLE AVE

32 Vaille Avenue Location

Kind of Pipe PVC Size 6" Size of Main 8"

Repair—Renewal—(New Service) Valeri #4807 Location

| Date | Material | Amount | Total | Date | | Amount |
|---|---|---|---|---|---|---|
| 11/18/88 | 40' LF 6" PVC | | | | | |
| | 5' LF 4" PVC | | | | | |
| | REDUCER | | | | | |
| | 3.5' LF 6" CHIMNEY | | | | | |
| | 8X6 WYE | | | | | |

DATE _____

TOWN OF LEXINGTON — BOARD OF PUBLIC WORKS

## SEWER DIVISION

Sketch of Service Here 32

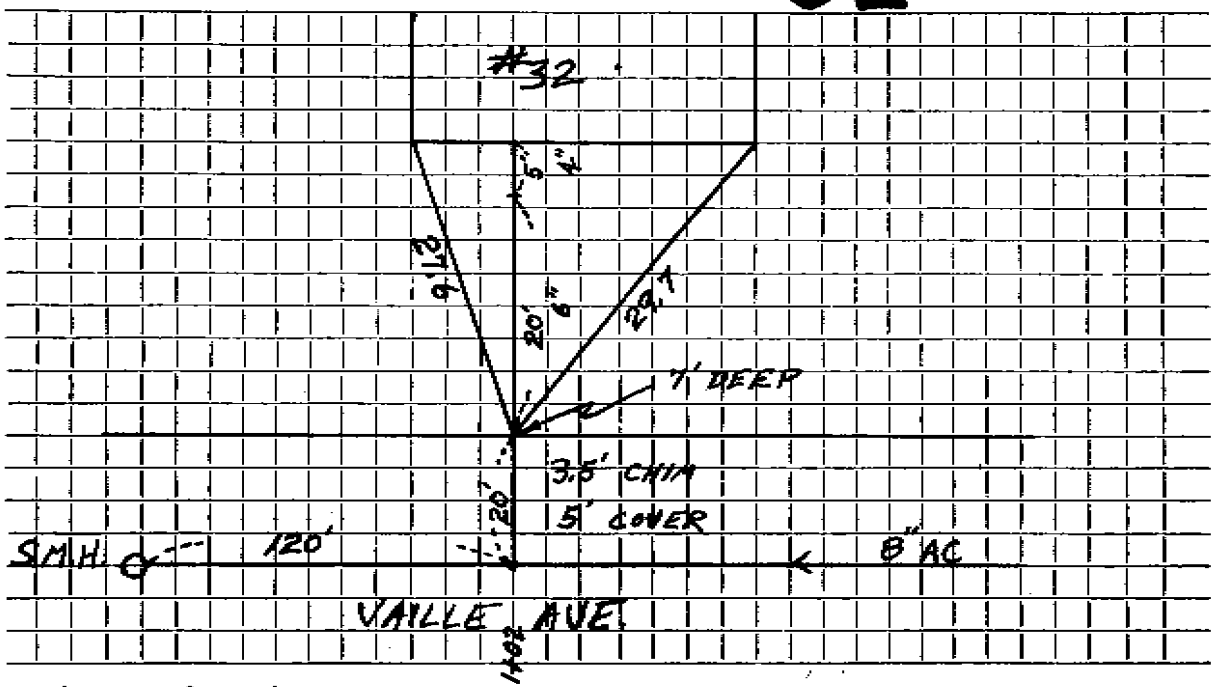


Connection made in VAILLE AVE. Street. Work completed .....

Remarks: Original Service 6-12-68