Name Stratven Realty — Service No. 181

Address 30 Valleyfield Street

Lot #102 30 Valleyfield Street Location

Kind of Pipe — Size 6" — Size of Main 8"

Repair—Renewal—New Service Kirkland & Shaw #898 — Location

MAY 13 1968

Date		Material	Amount	Total	Date		Amount
'66	21'	6" Transite pipe @5.00		105.00	12-5-67	Deposit	105.00
1-67	20'	6" Transite pipe					
	10'	4" Cast Iron pipe					

A

DATE _____

TOWN OF LEXINGTON — BOARD OF PUBLIC WORKS

SEWER DIVISION

Sketch of Service Here 30

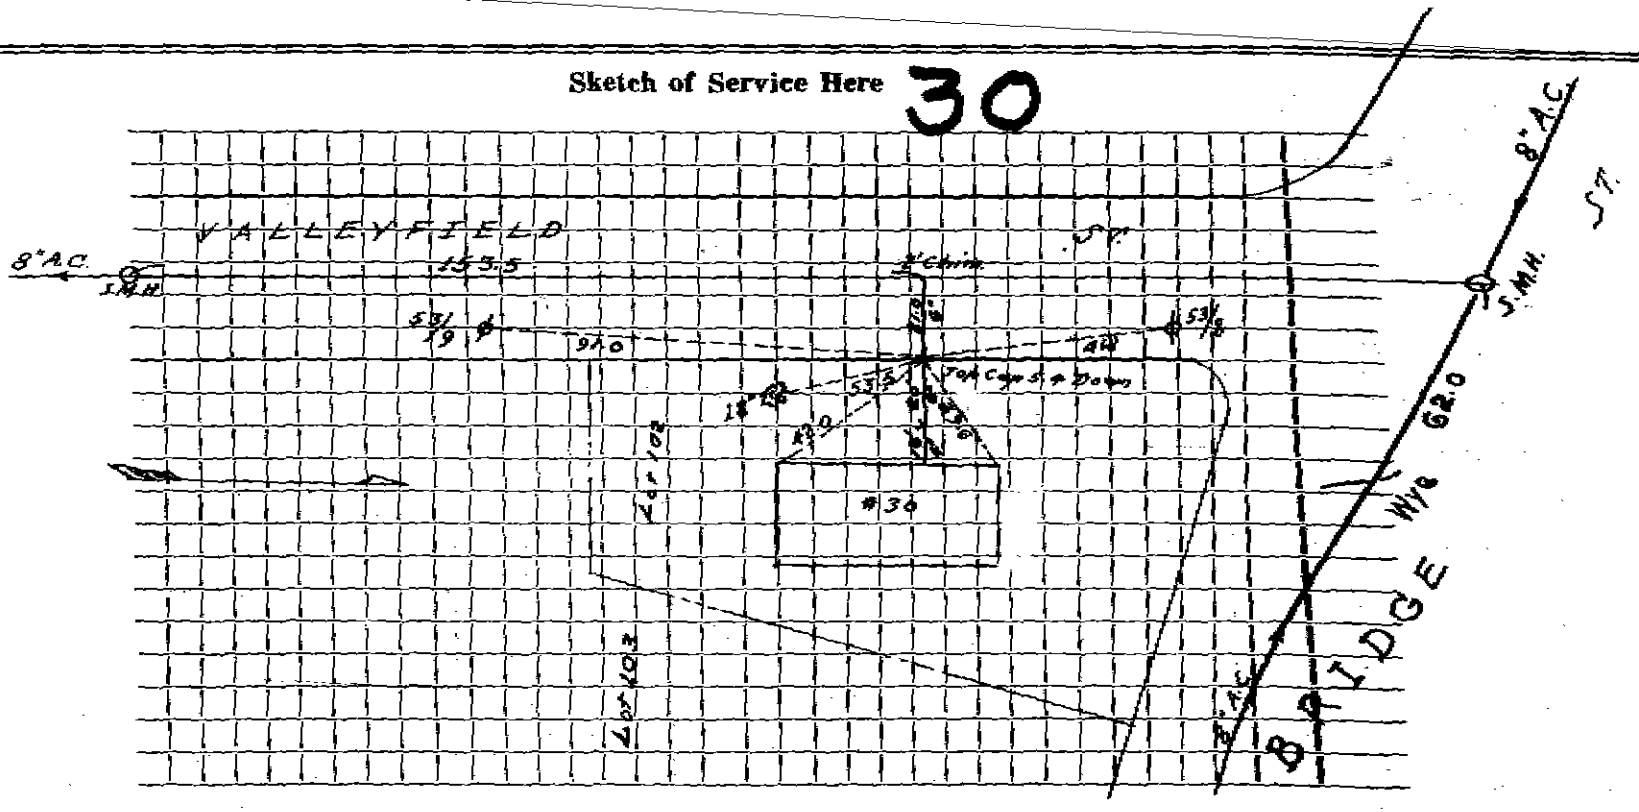

Connection made in ..... Street. Work completed .....

Remarks: .....

.....

.....