Name Wm. ~~[illegible]~~ Hooper **Service No.** 102

Address 50 Valleyfield Street

50 Valleyfield Street **Location**

Kind of Pipe **Size** 6" **Size of Main** 8"

Repair—Renewal—New Service Suburbanite #754 **Location** Conn 10-30-67

Date		Material	Amount	Total	Date		Amount
1 '66	21'	6" Transite pipe @5.00		105.00	8-24-67	Deposit	105.00
-13-67	32'	4" Cast Iron pipe					

3501

DATE _____

TOWN OF LEXINGTON — BOARD OF PUBLIC WORKS

SEWER DIVISION

Sketch of Service Here 50

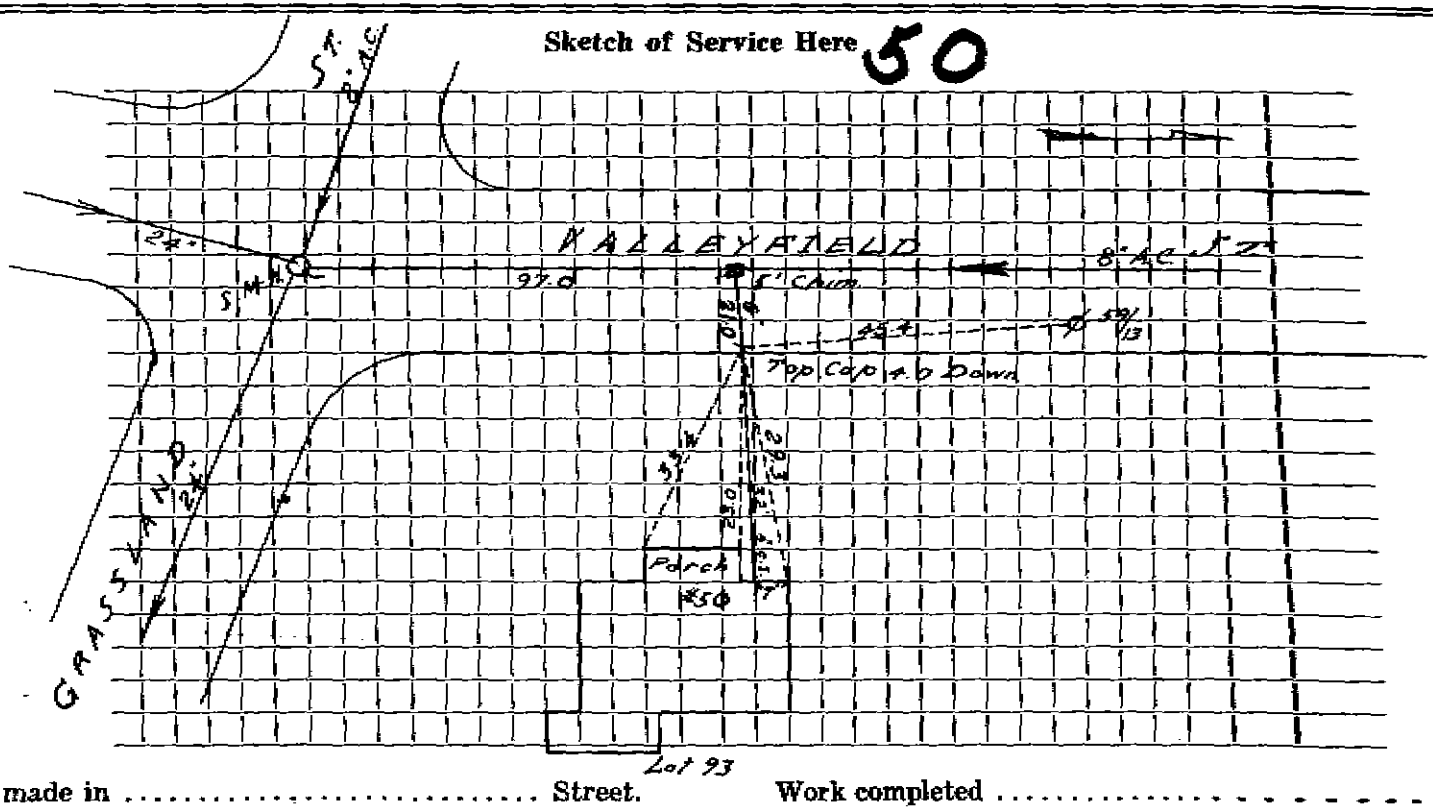

Connection made in ..... Street. Work completed .....

Remarks: .....

.....

.....