Name Francis Rosa **Service No.** 174

Address 58 Valleyfield Street

58 Valleyfield Street **Location**

Kind of Pipe Permit #A 19 **Size** 6" **Size of Main** [redacted]

~~Repair Department~~ **New Service** T. D. Sullivan & Son **Location** DEC 31 1965

Date		Material	Amount	Total	Date		Amount
965	23	6" Transite pipe @7.00		161.00	9-28-65	Deposit	161.00
0-11-65	74	6" Transite pipe					

1502

DATE _____

TOWN OF LEXINGTON — BOARD OF PUBLIC WORKS

SEWER DIVISION

Sketch of Service Here 58

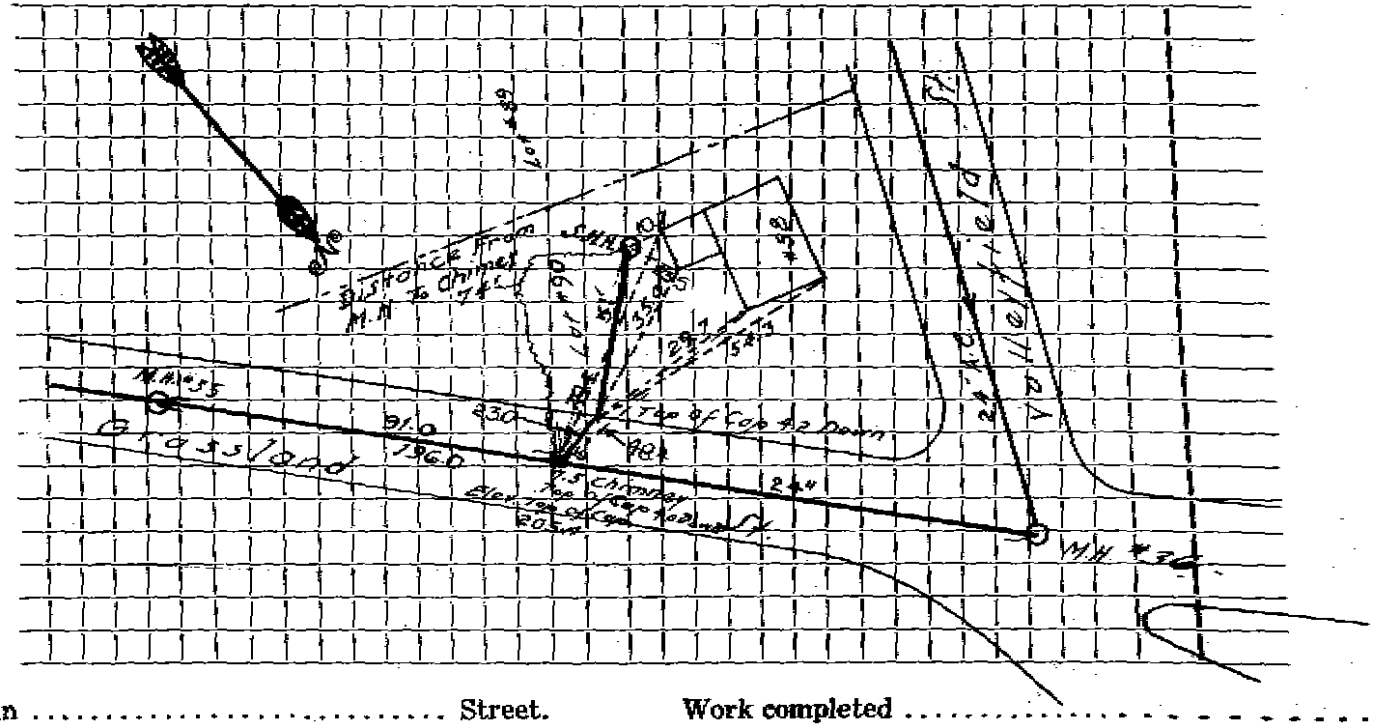

Connection made in ..... Street. Work completed .....

Remarks: .....

.....

.....