Name Louis Stoico **Service No.**

Address 2 Village Circle

Lot #2 2 Village Circle **Location**

Kind of Pipe **Size** 6" **Size of Main** 10"

[redacted] **New Service** Lugente #[redacted] 2317 **Location**

Date		Material	Amount	Total	Date		Amount
0-19-70	35'	6" Transite pipe					
5-21-73	10'	4" Cast Iron pipe					
	28'	6" Transite pipe					

S.N.10501

DATE _____

TOWN OF LEXINGTON — BOARD OF PUBLIC WORKS

SEWER DIVISION

Sketch of Service Here **2**

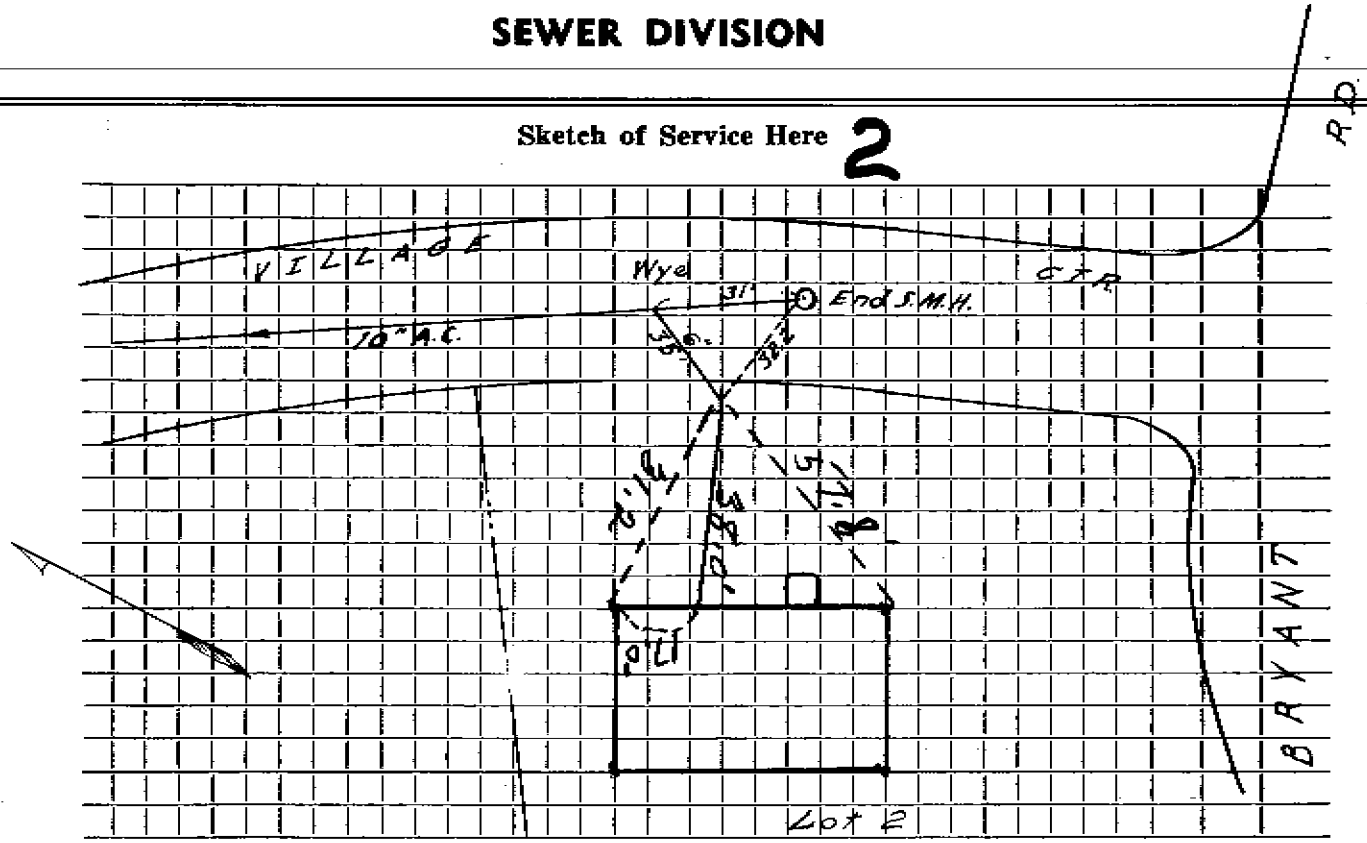

Connection made in ..... Street. Work completed .....

Remarks: .....

.....

.....