Name F. Mazzone **Service No.** 137

Address 38 Vine Street

Vacant Lot 38 Vine STreeT **Location**

Kind of Pipe **Size** 6" **Size of Main** 8"

Repair ~~**Renewal**~~ **New Service** Trebino Const. Co. Permit #443 **Location** MAY 2 1966

Date		Material	Amount	Total	Date		Amount
10-65	18'	6" Transite pipe @	7.00	126.00	8-17-65	Deposit	126 00
5	25'	6" Transite pipe					

DATE _____

TOWN OF LEXINGTON — BOARD OF PUBLIC WORKS

SEWER DIVISION

Sketch of Service Here 38

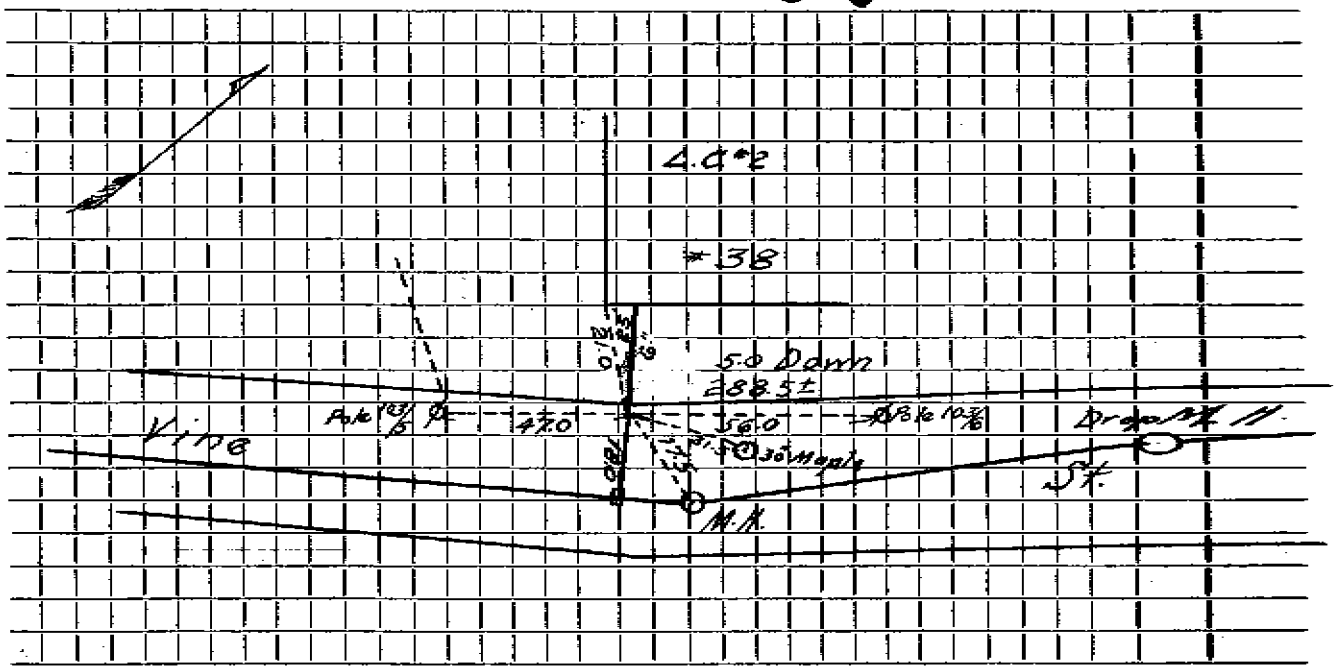

Connection made in ..... Street. Work completed .....

Remarks: .....

.....

.....