Name SWAN **Service No.**

Address 65 Vine Street

Lot Across Hse. #67 Vacant Lot **Location**

Kind of Pipe **Size** 6" **Size of Main** 8"

Repair ~~**Renewal**~~ **New Service** **Location**

Date		Material	Amount	Total	Date		Amount
11-65	16"	6" Transite pipe @ 2.00		112.00			

DATE _____

TOWN OF LEXINGTON — BOARD OF PUBLIC WORKS

SEWER DIVISION

Sketch of Service Here

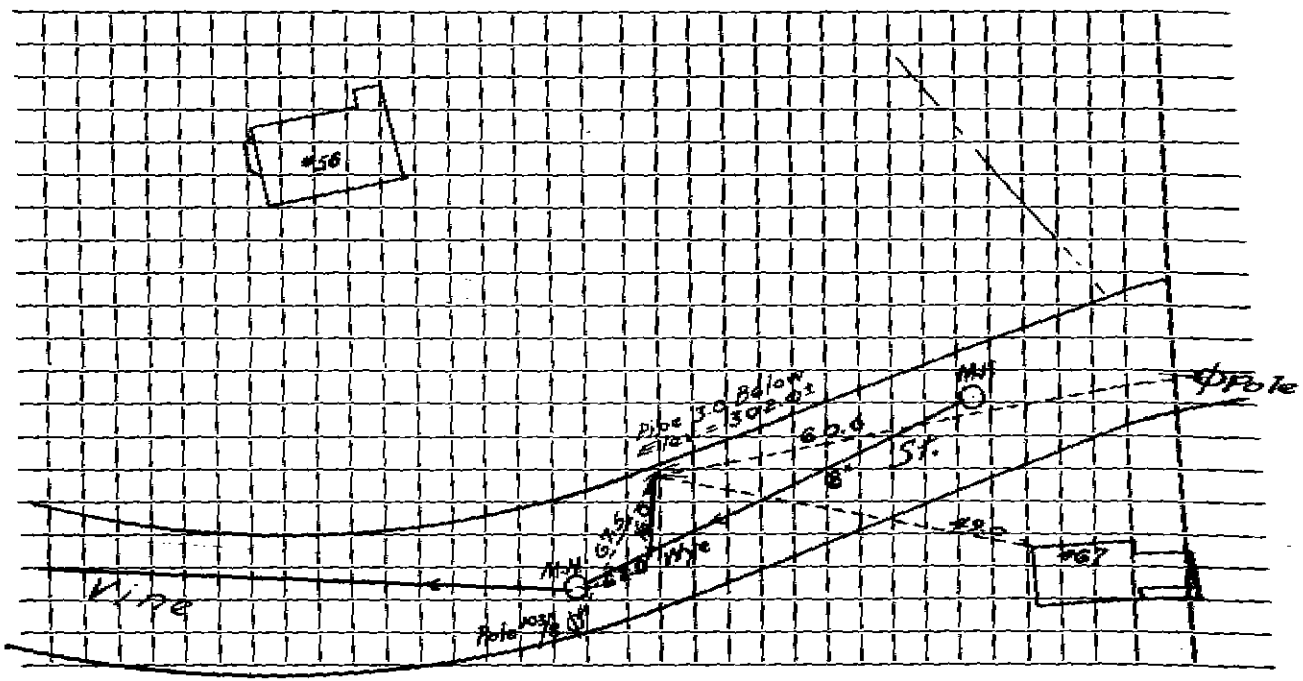
#56
#67
Pipe
Pole
Pole
Pole