Name Robert Berg **Service No.** 47

Address 2 4 Wachusett Drive

24 Wachusetts Drive **Location**

Kind of Pipe DeFlice Bros #A253 **Size** 6" **Size of Main** 8"

[redacted] **New Service** W.O. #2300 **Location** SEP 19 1966

Date		Material	Amount		Total		Date			Amount	
3-66		Labor 54.80					4-26-66		Deposit	150	00
3-66		Patching 34.35	89	15			16-4-66		Paid	43	42
		10% O.H.	8	92	98	07				193	42
	26'	6" Water pipe @ 1.95			50	70					
		1 Bag Cement			1	55					
	20	Brick @ 4.20 per 100				85					
	1	Ton cold patch			5	00					
	2½	Ton hot top @ 5.50			13	75					
	4½	Town Truck @ 3.00			13	50					
	1	Hr. Roller			3	00					
	1	Hr. Compressor			5	00					
	1	Hr. Trailer			2	00					
					193	42					
/66	28'	6" Transite pipe									
									Bill sent 43.42		

DATE _____

TOWN OF LEXINGTON — BOARD OF PUBLIC WORKS

SEWER DIVISION

Sketch of Service Here 24

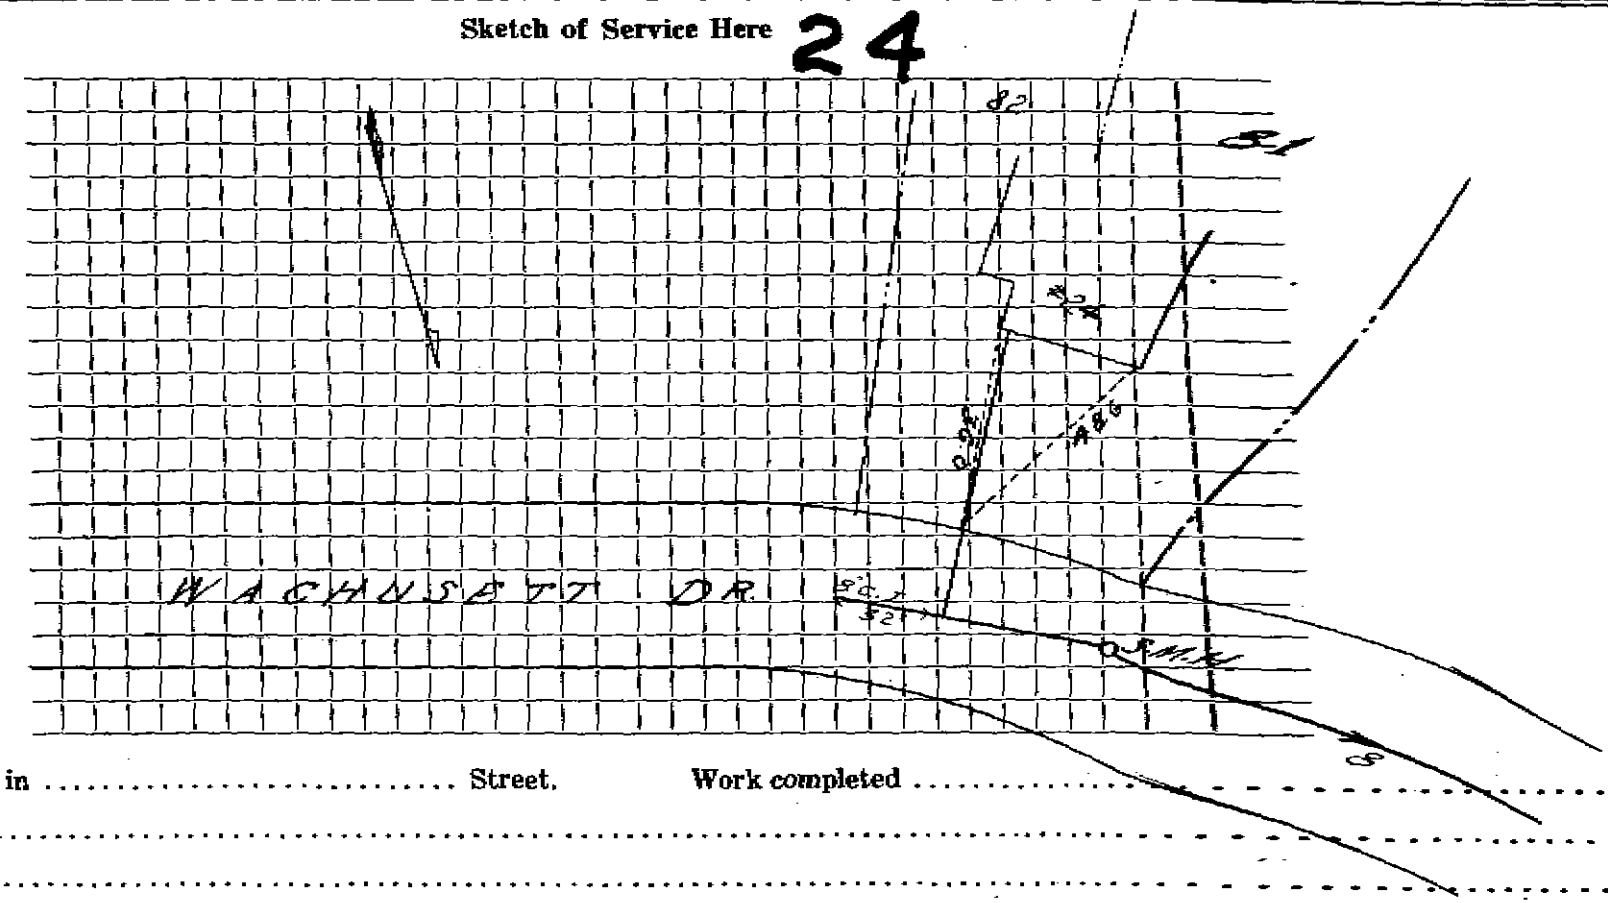

Connection made in ..... Street. Work completed .....

Remarks: .....

.....

.....