Name

Service No.

Address 26 Wachusetts Drive

26 Wachusetts Drive

Location

Kind of Pipe

Size 6"

Size of Main 8"

Repair—Renewal—New Service

Location

Date		Material	Amount		Total		Date			Amount	
10/16	76	135' - 4" C.I.									

F.B.N.18601

DATE _____

TOWN OF LEXINGTON — BOARD OF PUBLIC WORKS

SEWER DIVISION

Sketch of Service Here

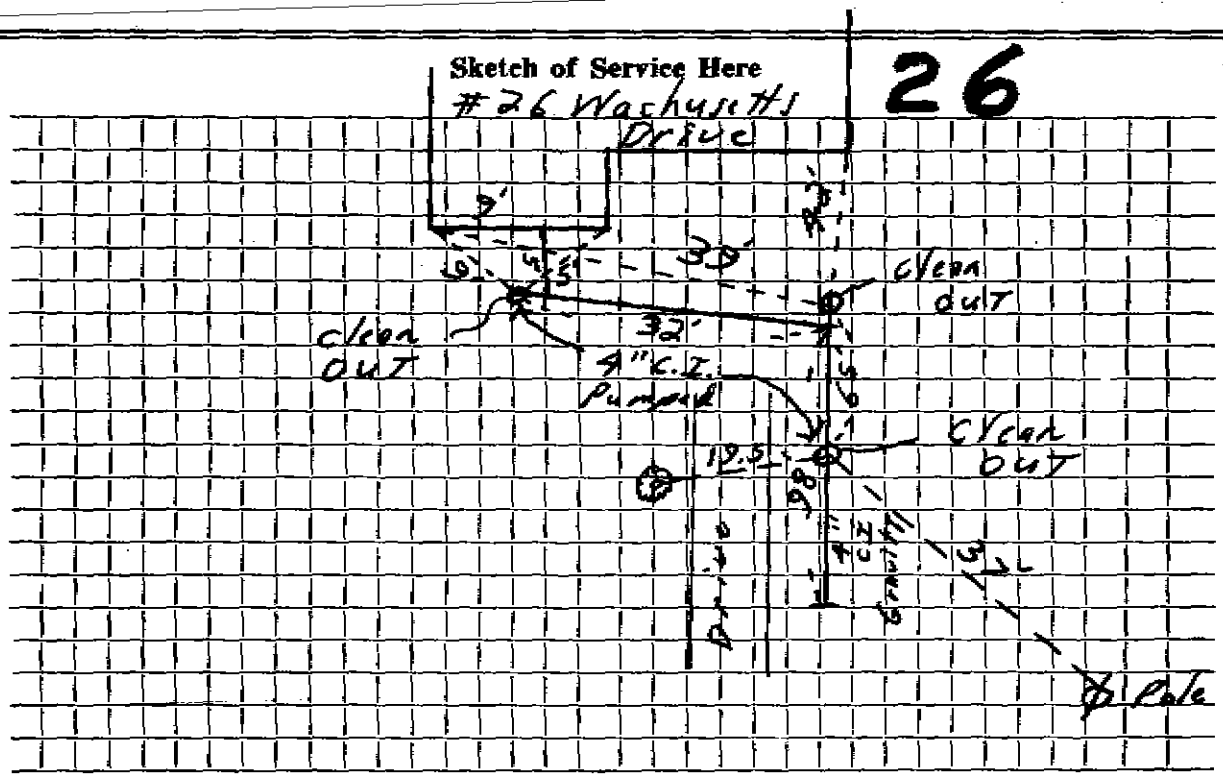

Connection made in ..... Street. Work completed .....

Remarks: .....

.....

.....