Name

Service No.

Address 10 + 12 Waltham St.

10 + 12 Waltham Street Location 10+12 Waltham Street

Kind of Pipe

Size 6"

Size of Main 8"

Repair—Renewal—New Service

Location

Date	Material	Amount	Total	Date		Amount
	Labor					

Hadley Press, Inc., Lexington

TOWN OF LEXINGTON—BOARD OF PUBLIC WORKS

SEWER DIVISION

DATE _____ NO. _____

The undersigned applies for the construction of a particular sewer connecting No. 10 & 12 Waltham St. Street and hereby agrees to comply with the Rules and Regulations governing the construction and use of Particular Sewers, as now or at any future time established by the Board of Selectmen.

Am't. of Estimate $ _____

Am't. Paid $ _____

_____ Owner

Sketch of Service Here

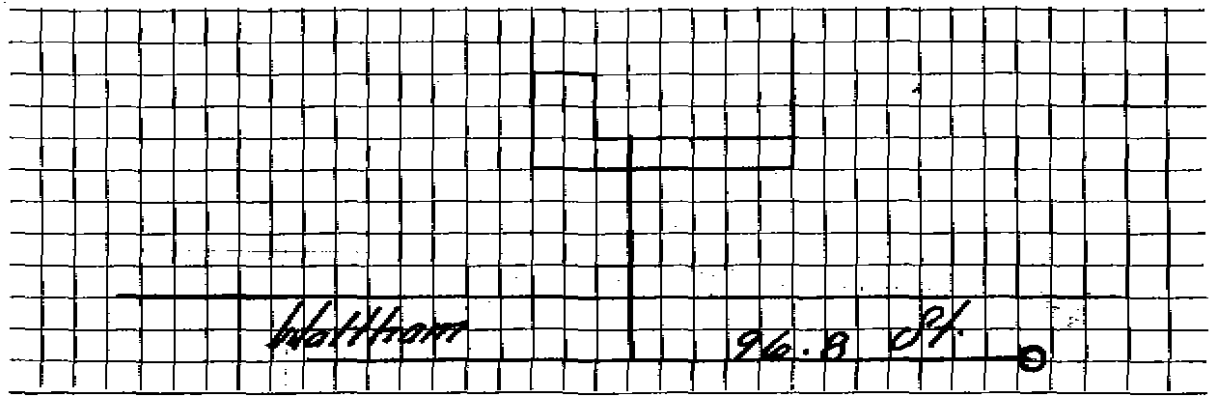

Connection made in _____ Street. Work completed _____ 19

Remarks: