Name

Service No.

Address #1010 WALTHAM ST

1010 Waltham Street

Location

Kind of Pipe AC

Size 6"

Size of Main 8"

Repair—Renewal—New Service

Location

Date	Material	Amount	Total	Date		Amount
9/1/76	11-6"AC@$10	$10 —	110 00			
8/22/77	ABATED BY SELECTMEN (damage from Sewer Easement)					
	Jerry Martin 12/5/77					

B.N.18501

DATE _____

TOWN OF LEXINGTON — BOARD OF PUBLIC WORKS

SEWER DIVISION

Sketch of Service Here 1010

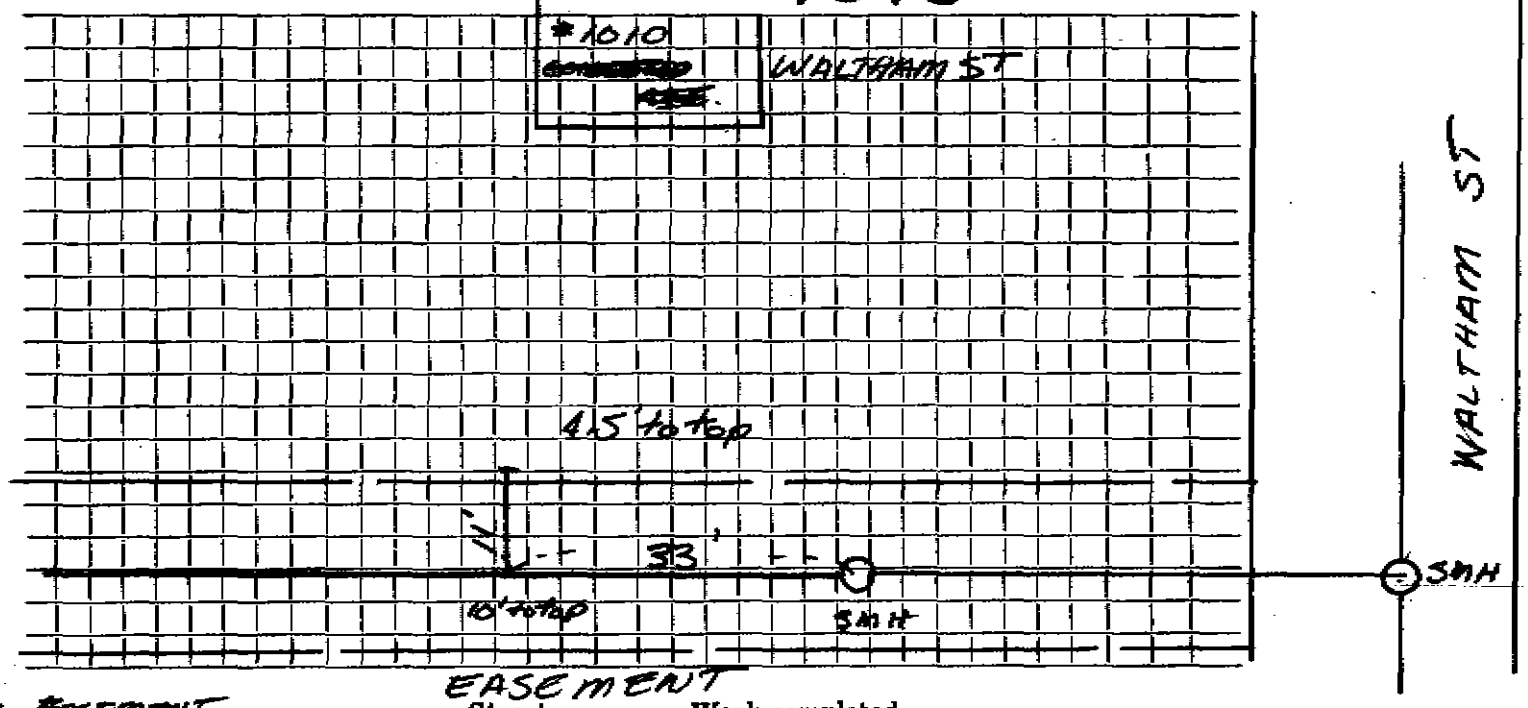

Connection made in EASEMENT WALTHAM TO CONCORD AVE Street. Work completed .....

Remarks: .....