Name JG ENTERPRISES Service No.

Address #365 & #367 WALTHAM STREET

365-367 Waltham STreet Location

Kind of Pipe Size 6" Size of Main 8"

Repair Renewal **New Service** PERMIT NO. 0676 McLaughlin Location

Date	Material	Amount	Total	Date		Amount
1995	166' PVC 6"					
	5' 4"					
	31' Ductile 6"					

DATE 5 OCTOBER 1995

TOWN OF LEXINGTON — BOARD OF PUBLIC WORKS

SEWER DIVISION

Sketch of Service Here 365-367

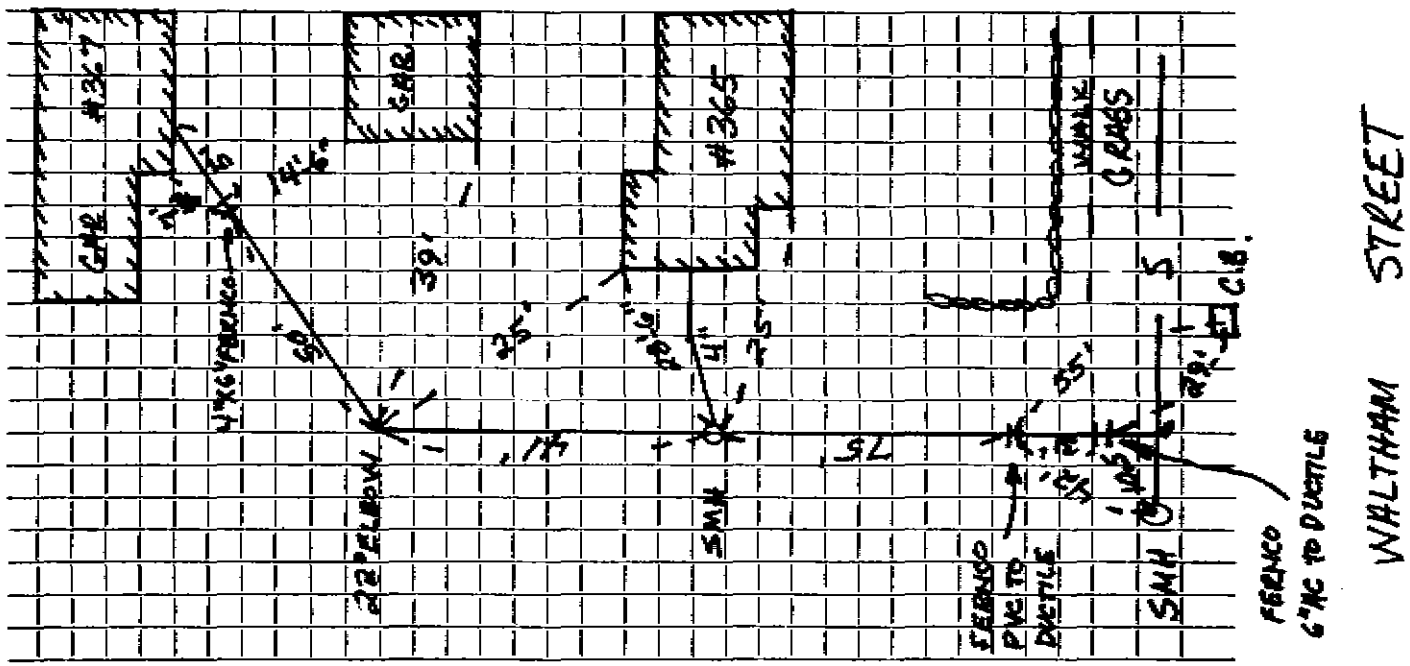

Connection made in WALTHAM STREET Street. Work completed J.M. McLaughlin

Remarks:

BOOK 96A