Name Richard McDevitt

Service No.

Address * ~~283~~ 83 Waltham St Lot 17

283 Waltham Street

Location

Kind of Pipe

Size 6"

Size of Main 8"

Repair—Renewal—New Service

Location

Date		Material	Amount	Total	Date		Amount
66	23'	6" Transite Pipe @5.00		115.00			

DATE _____

TOWN OF LEXINGTON — BOARD OF PUBLIC WORKS

SEWER DIVISION

Sketch of Service Here 483

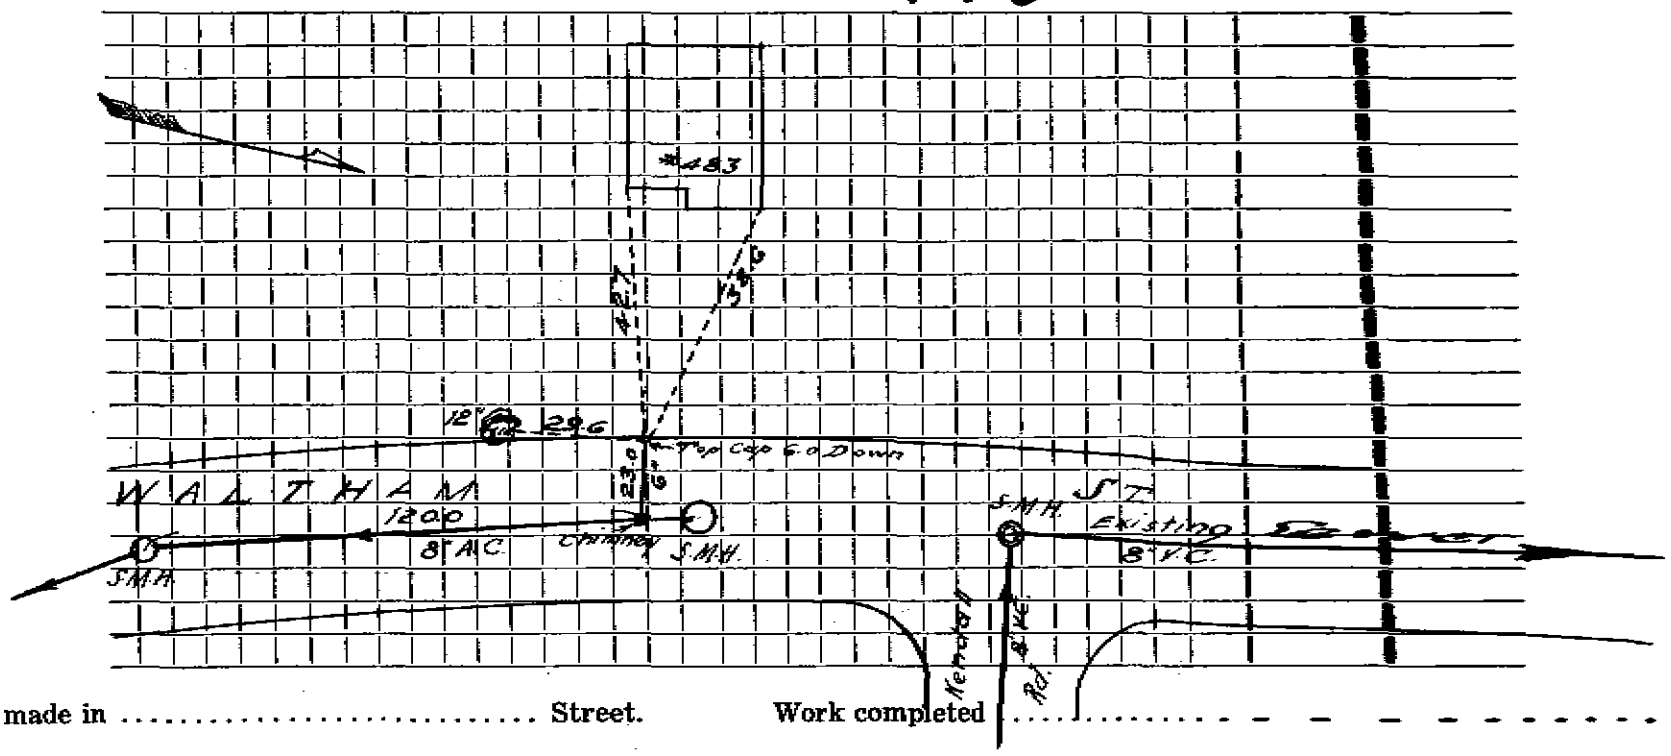

Connection made in ..... Street. Work completed .....

Remarks: .....

.....

.....