Name Frank B. Stowell Service No. 69

Address # 498 Waltham St. Lot 132

498 Waltham Street Location

Kind of Pipe Size 6" Size of Main 8"

Repair ~~Renewal~~ New Service Lexington Sewerage #1635 Location JUL 26 1971

Date		Material	Amount	Total	Date		Amount
'66	40'	6" Transite @5.00		200.00	7-26-71	Deposit	200.00
'70	30'	6" Transite pipe					
	10'	4" Cast Iron pipe					

DATE _____

TOWN OF LEXINGTON — BOARD OF PUBLIC WORKS

SEWER DIVISION

Sketch of Service Here 498

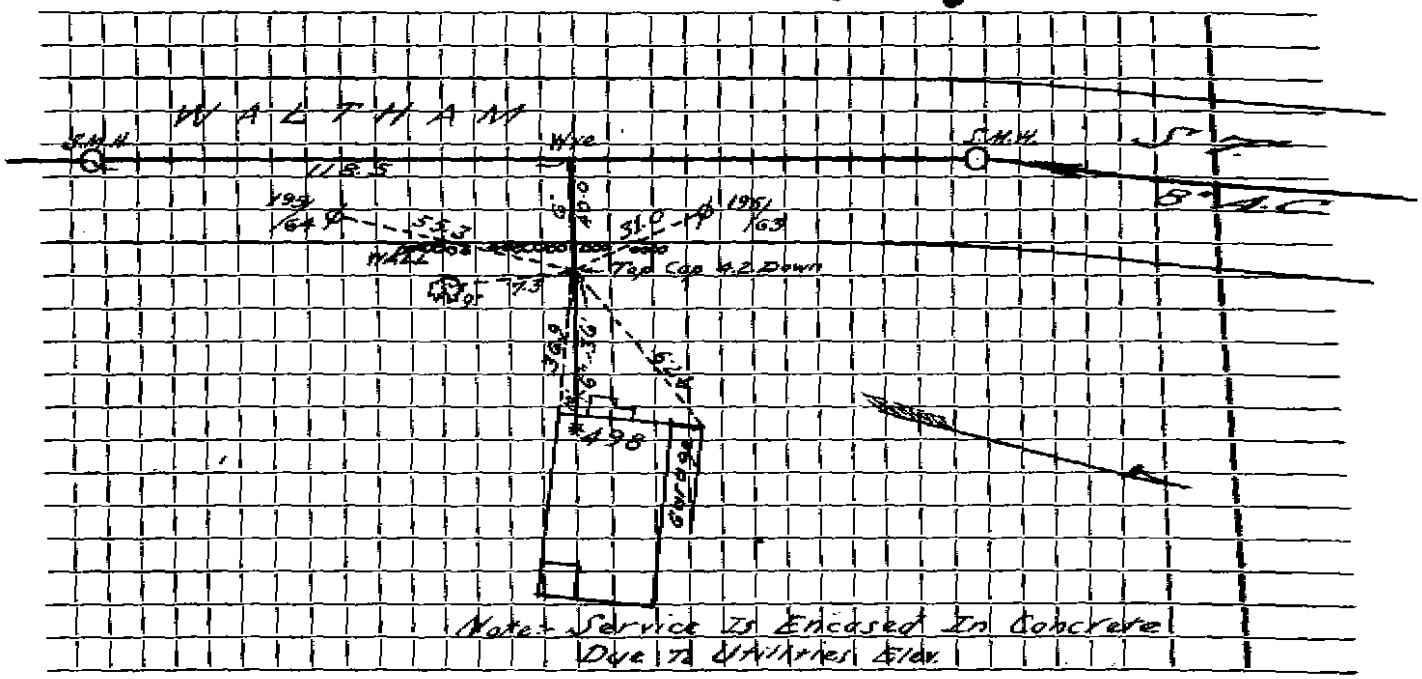

Connection made in ..... Street. Work completed .....

Remarks: .....

.....

.....