Name NAOMI YANG Service No.

Address #674 WALTHAM STREET

674 Waltham STreet Location

Kind of Pipe Size 6" Size of Main 8"

Repair—Renewal—New Service SEPTIC ABANDONMENT-Ado #08847 Location

Date		Material	Amount		Total		Date			Amount	
7/23	96	133' PVC									
							6-15-	77			
								31'	6" Transite		

DATE 25 JULY 1996

TOWN OF LEXINGTON — BOARD OF PUBLIC WORKS

SEWER DIVISION

Sketch of Service Here 674

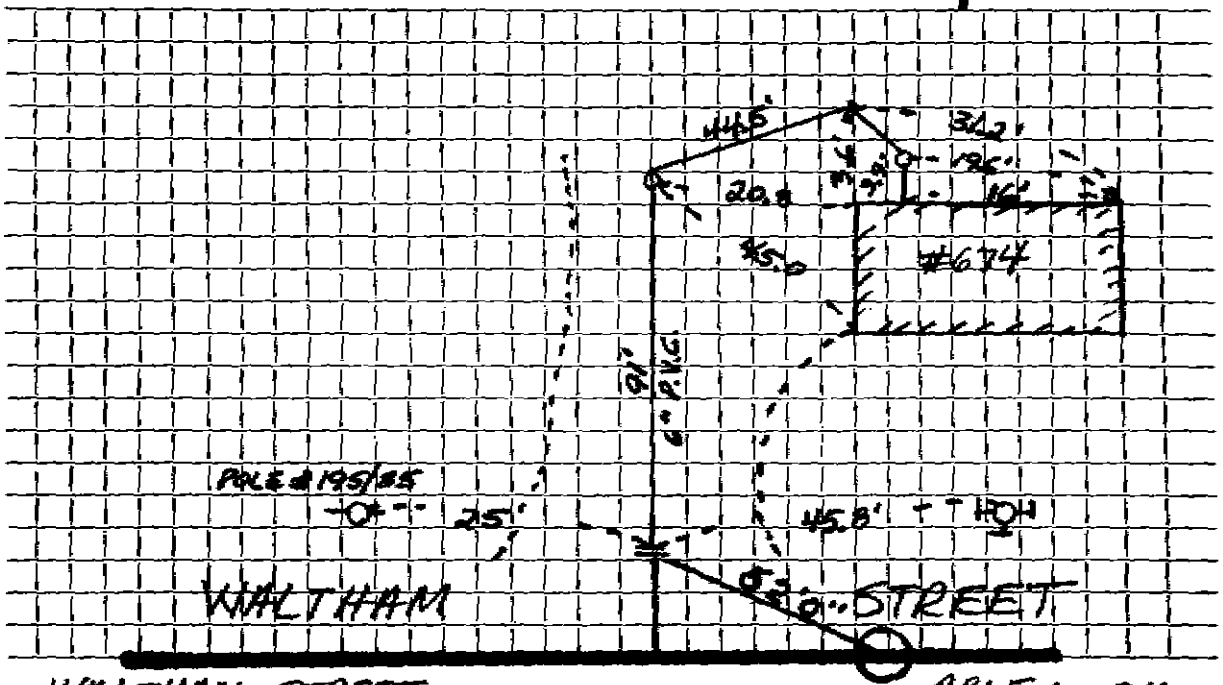

Connection made in WALTHAM STREET Street. Work completed ARLEX OIL COMPANY

Remarks:

BOOK 96A