Name Hugh McDonald Service No.

Address LOT # 740 WALTHAM ST.

740 Waltham Street Location

Kind of Pipe A.C. Size 6" Size of Main 8"

~~Repair/Remarks~~ New Service James McLaughlin #4364 Location

Date		Material	Amount	Total	Date		Amount
6-6	77	30' 6" AC @	$10.00	$300 00	4-26-87	Deposit	300 00
4/27/87	87'	6" PVC					
	6.9"	4" PVC					
	1	4" x 6" Fernco					
	1	6" PVC to 6" AC Fernco					
	1	45° Bend					

B.K.18501

DATE _____

TOWN OF LEXINGTON — BOARD OF PUBLIC WORKS

SEWER DIVISION

Sketch of Service Here 740

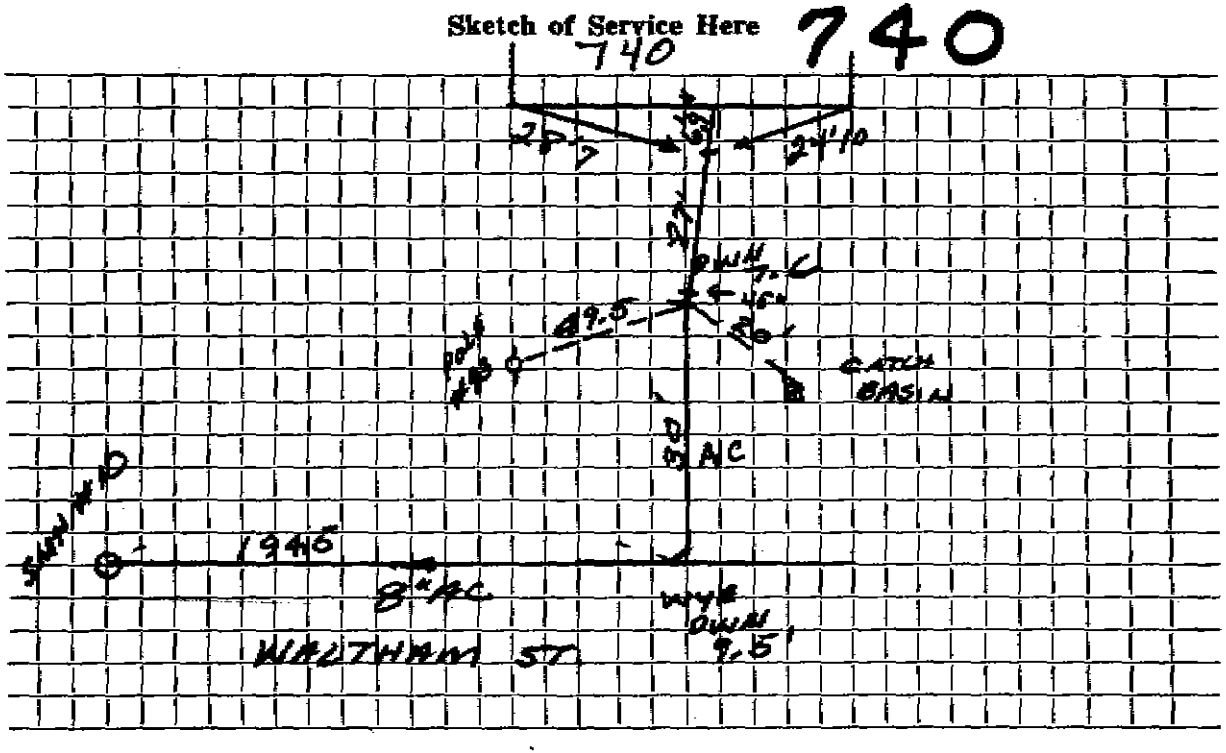

Connection made in ..... Street. Work completed .....

Remarks: .....

.....

.....