Name Peter Kozel **Service No.** 12

Address # 983 WALTHAM ST.

983 Waltham Street **Location**

Kind of Pipe PVC **Size** 6" **Size of Main** 8"

~~Repair~~—~~Renewal~~—**New Service** Suburbanite #3786 **Location** MAY 31 1983

Date		Material	Amount	Total	Date		Amount
11/10/82		26 LF 6" PVC	$16.00/LF	$416.00	53-53	Deposit	$416.00
5/9/83	36'	x 6" P.V.C.					
	10'	x 4" C.I.P.					
	1	6" x 4" Donut					

DATE MAY 9, 1983

TOWN OF LEXINGTON — BOARD OF PUBLIC WORKS

SEWER DIVISION

Sketch of Service Here 983

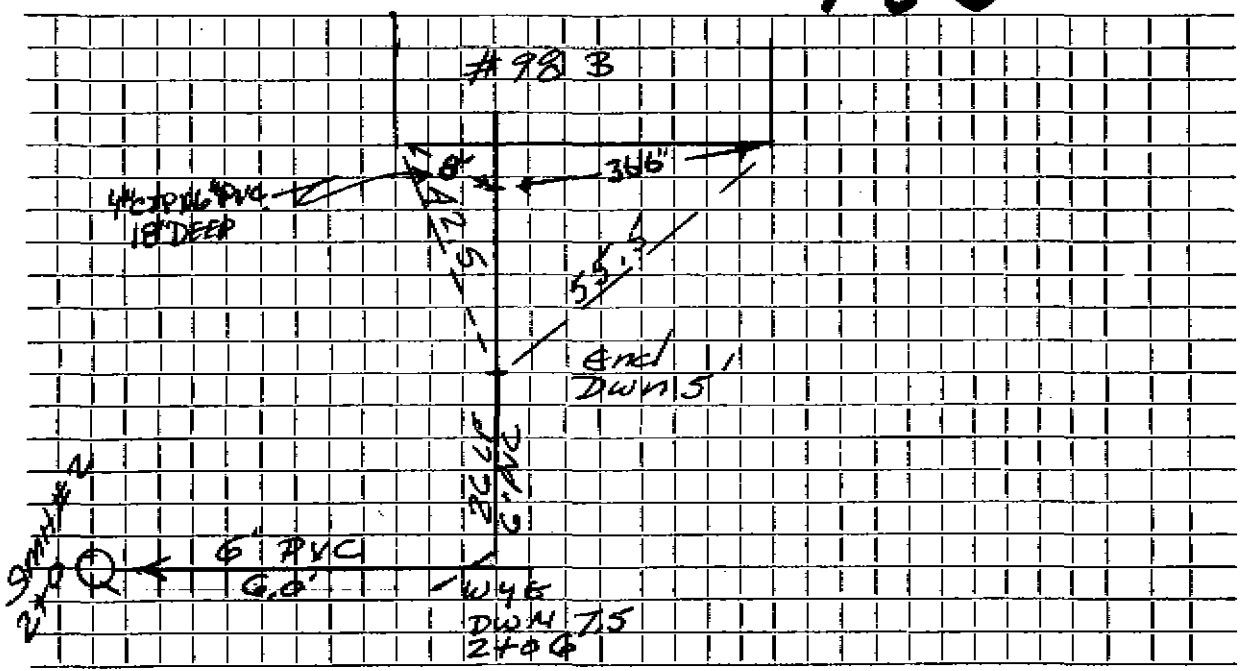

Connection made in WALTHAM ST Street. Work completed MAY 9, 1983

Remarks: