Name

Service No.

Address VACANT LOT #1 WALTHAM ST.
(Around #277)

Location

Kind of Pipe AC THIS SERVICE USED FOR 9 BUSHNELL DR.

Size

Size of Main

Repair—Renewal—New Service See CARD 9 Bushnell DR

Location

| Date | Material | Amount | Total | Date | | Amount |
|---|---|---|---|---|---|---|
| 7/10/79 | 42.9 46" ACP @ | 1700/FT = | $714.00 | | | |

DATE _____

# TOWN OF LEXINGTON — BOARD OF PUBLIC WORKS

## SEWER DIVISION

Sketch of Service Here

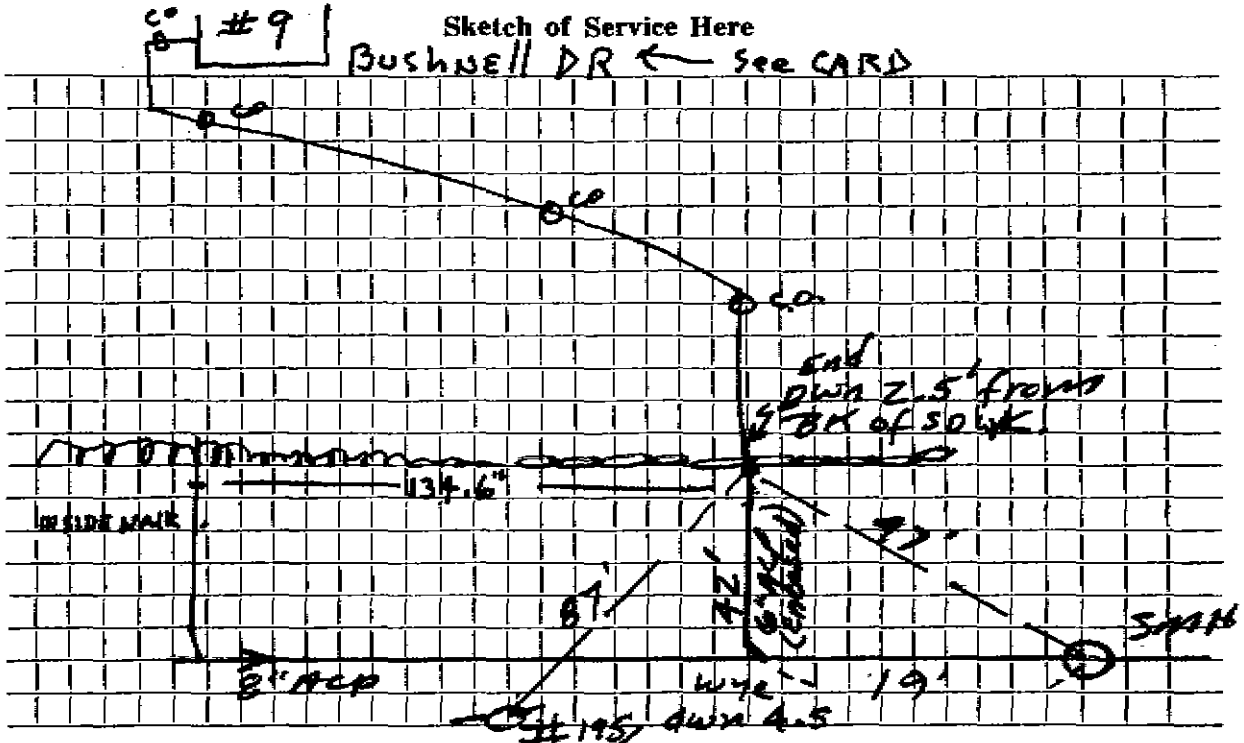


Connection made in ....Waltham..... Street. Work completed .....

Remarks: Pipe is encased in concrete.....