Name **Service No.**

Address Ward Street

Lots 4 & 5 Blk.2 **Location**

Kind of Pipe **Size** **Size of Main**

Repair—Renewal—New Service **Location**

Date		Material	Amount	Total	Date		Amount
7	25'	6" Transite pipe @7.00		175.00			

18501

DATE _____

TOWN OF LEXINGTON — BOARD OF PUBLIC WORKS

SEWER DIVISION

Sketch of Service Here

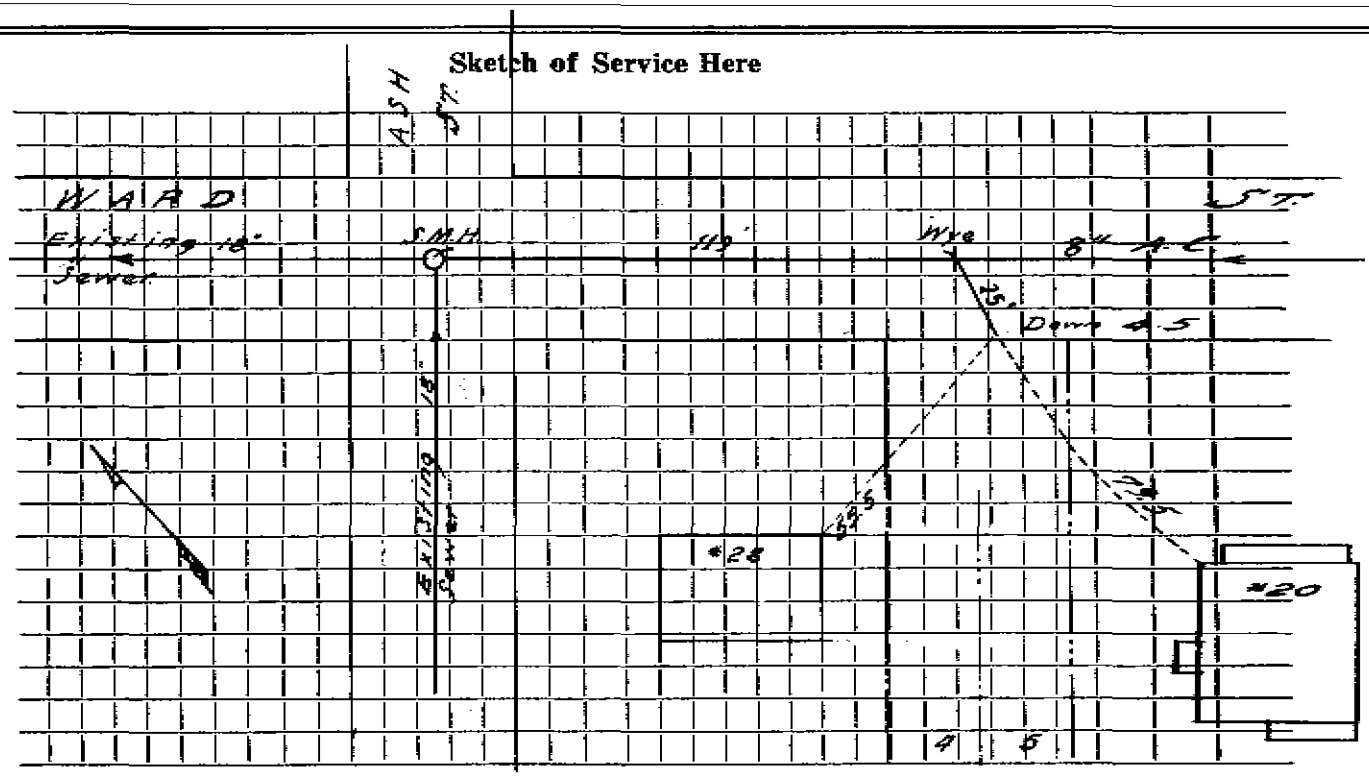

Connection made in ..... Street. Work completed .....

Remarks: .....

.....

.....