Name Edward Andrews **Service No.** 215

Address 18 Watertown Street

18 WaTerTown STreeT **Location**

Kind of Pipe DeFlice Bros. Permit #A66 **Size** 6" **Size of Main** 8"

~~X Replace~~ ~~X~~ **New Service** **Location** MAY 2 1966

Date		Material	Amount	Total	Date		Amount
65	36½	6" Transite pipe @5.00		182.50	11-1-65	Paid	182.50
23/66	15	6" Transite Pipe					

DATE _____

TOWN OF LEXINGTON — BOARD OF PUBLIC WORKS

SEWER DIVISION

Sketch of Service Here 18

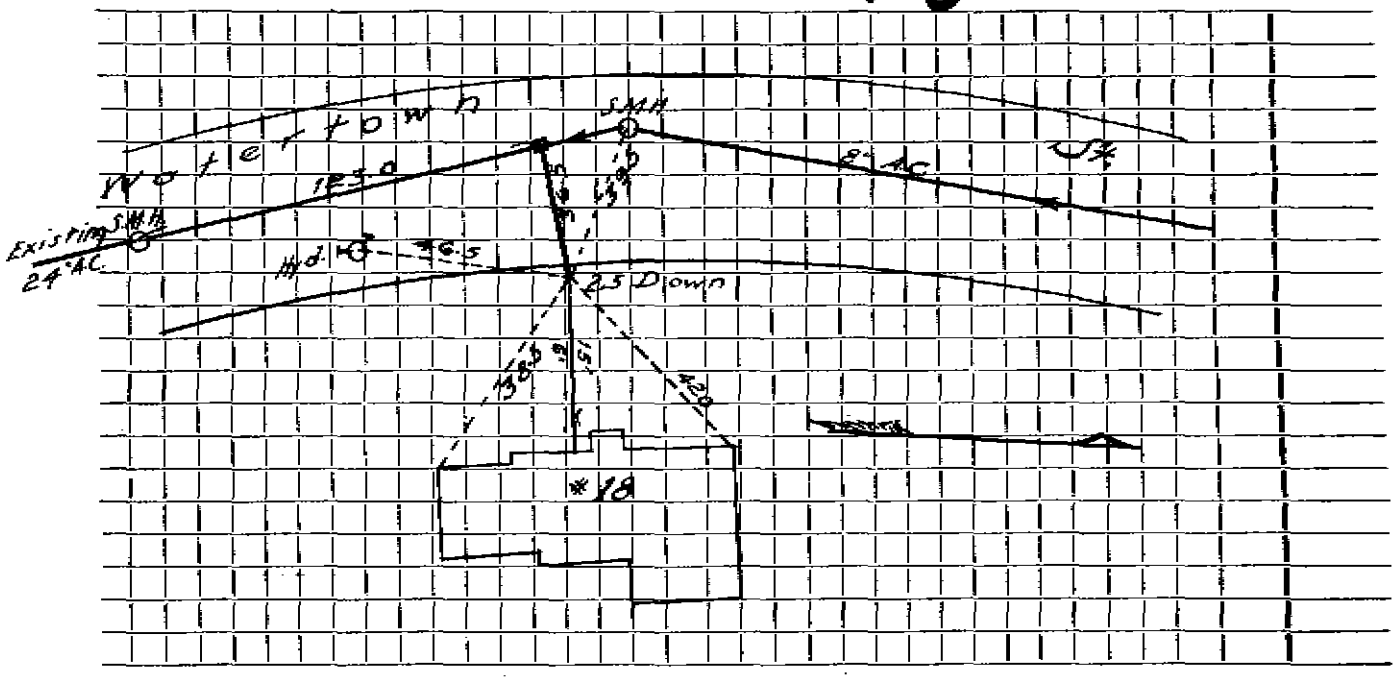

Connection made in ..... Street. Work completed .....

Remarks: .....

.....

.....