Name **Service No.**

Address

22 Water Town Street **Location**

Kind of Pipe **Size** 6" **Size of Main** 8"

Repair—Renewal—New Service **Location**

Date		Material	Amount	Total	Date			Amount
0-16-69								
	30'	6" Transite						
	10'	4" C. I. Pipe			10-14-68			
						23'	6" Transite	
						1	6"-90° Elbow	
						1	6"x8" Wye	

N.18501

DATE _____

TOWN OF LEXINGTON — BOARD OF PUBLIC WORKS

SEWER DIVISION

Sketch of Service Here 22

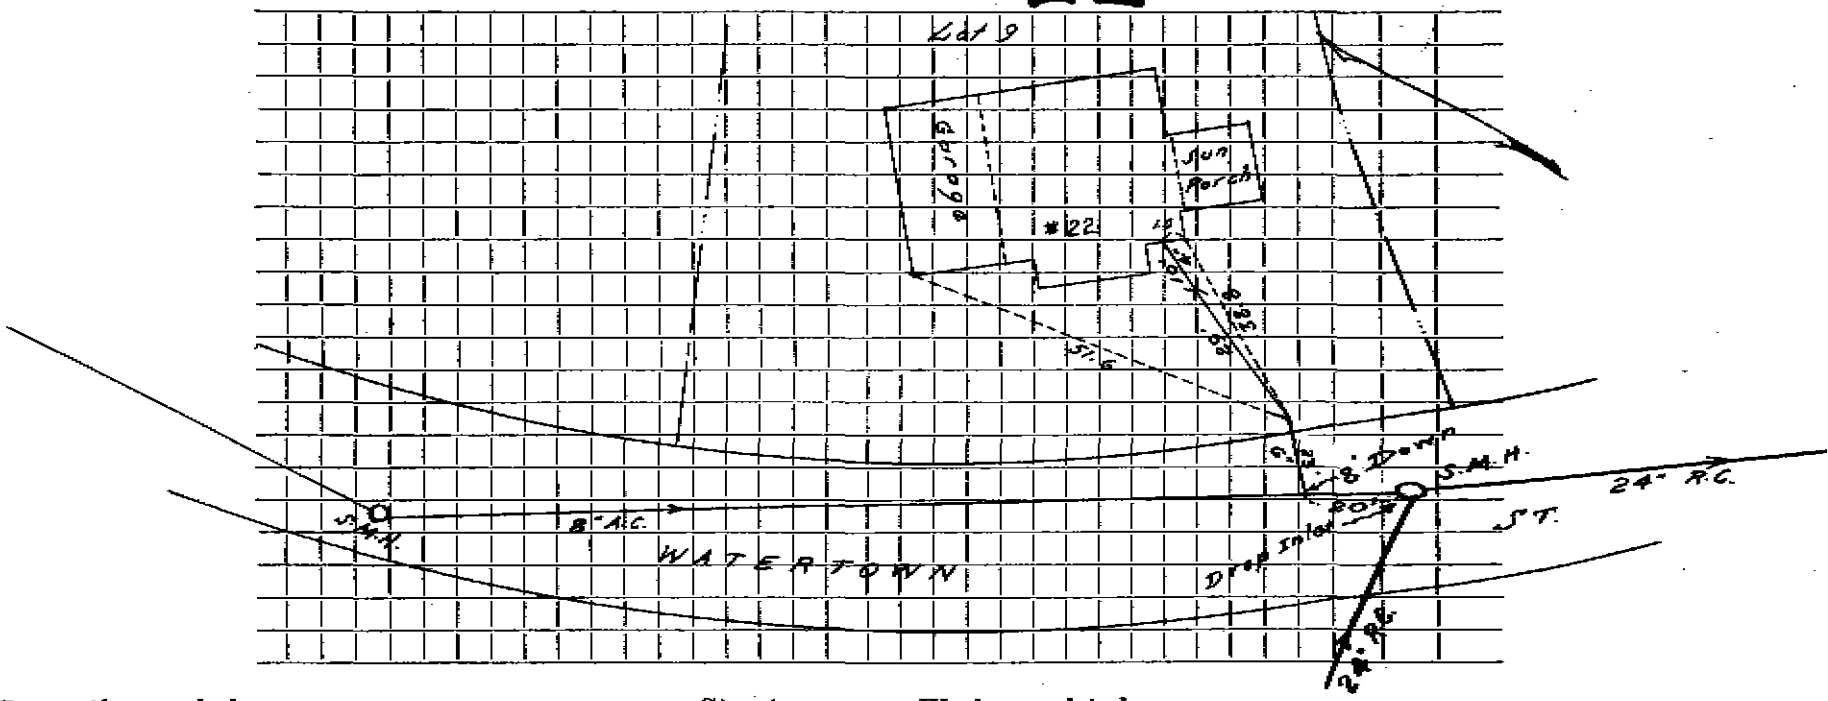

Connection made in ..... Street. Work completed .....

Remarks: .....

.....

.....