Name Robert Taggart **Service No.** 173

Address 63 WEBB ST

63 Webb STreeT **Location**

Kind of Pipe **Size** 6" A.C. **Size of Main** 8"

Repair—Renewal—New Service ✓ Valeri Const. #2421 **Location** APR 8 1974

Date	Material	Amount	Total	Date		Amount
8-9-73	18' 6" A.C @ $9.00	$162.00		11-13-73	Deposit	165.00
11-14-73	40' - 6" ACP					
	10' - 4" CI					

B.M.18501

DATE _____

TOWN OF LEXINGTON — BOARD OF PUBLIC WORKS

SEWER DIVISION

Sketch of Service Here 63

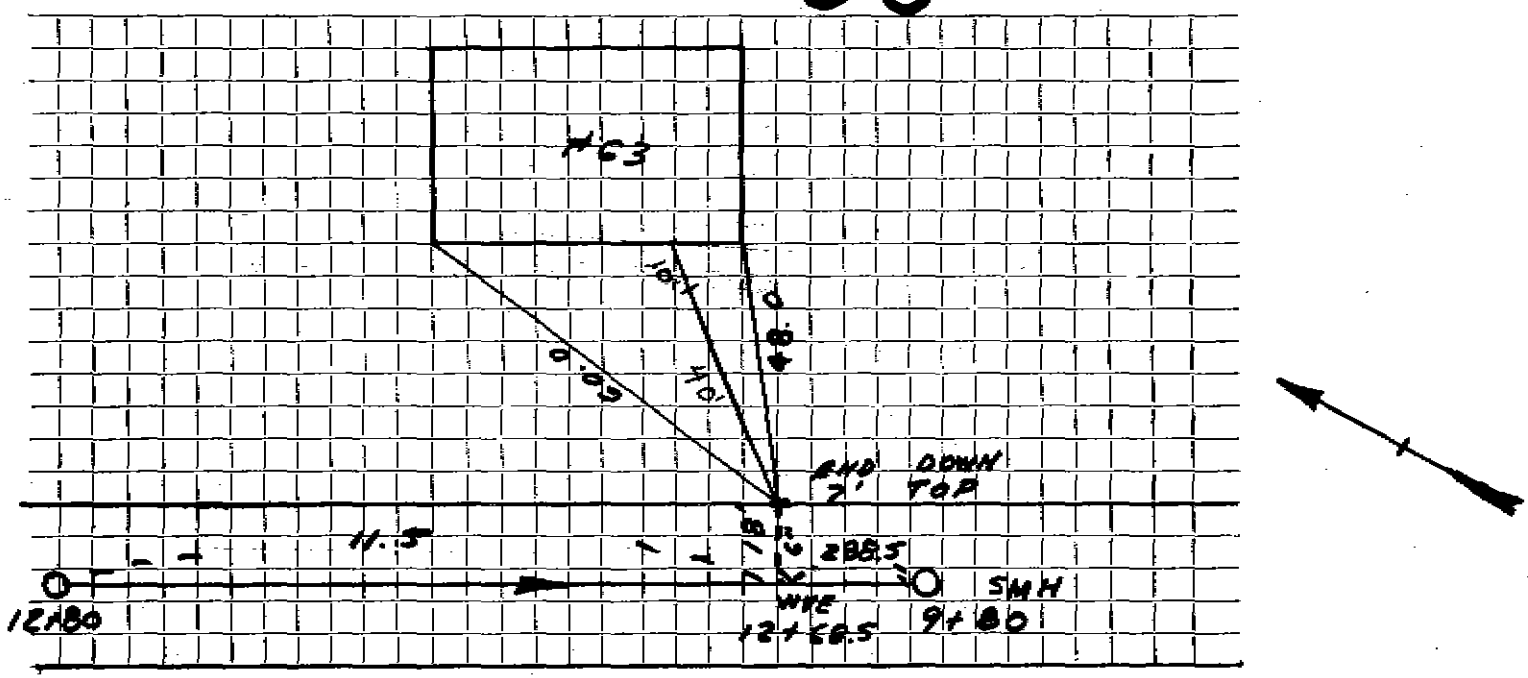

Connection made in ..... Street. Work completed .....

Remarks: .....

.....

.....