Name Mary D'Abbraccio **Service No.** 108

Address 14 Westminister Avenue

14 Westminster Avenue **Location**

Kind of Pipe **Size** 6" **Size of Main** 8"

~~Repair~~ ~~Renewal~~—**New Service** WO #7481 **Location** Comm 10-1-62

Date		Material	Amount	Total	Date		Amount
7-24-62		Labor	100.97		7-20-62	Deposit	200.00
		10% O.H.	10.10	111.07	5-15-64	Paid	5.58
	50'	6" Transite pipe @.78		39.00			205.58
	2	11¼° Transite Bends @4.09		8.18			
	2	6" Adapters @1.62		3.24			
	1	22½° Transite Bend		4.09			
	4	hrs. Town Shovel @6.50		26.00			
	2	hrs. Trucking @3.00		6.00			
	8 x 3	Patch		8.00			
				205.58			
						Bill sent 5-5-4	

S.M.18501

DATE _____

TOWN OF LEXINGTON — BOARD OF PUBLIC WORKS

SEWER DIVISION

Sketch of Service Here 14

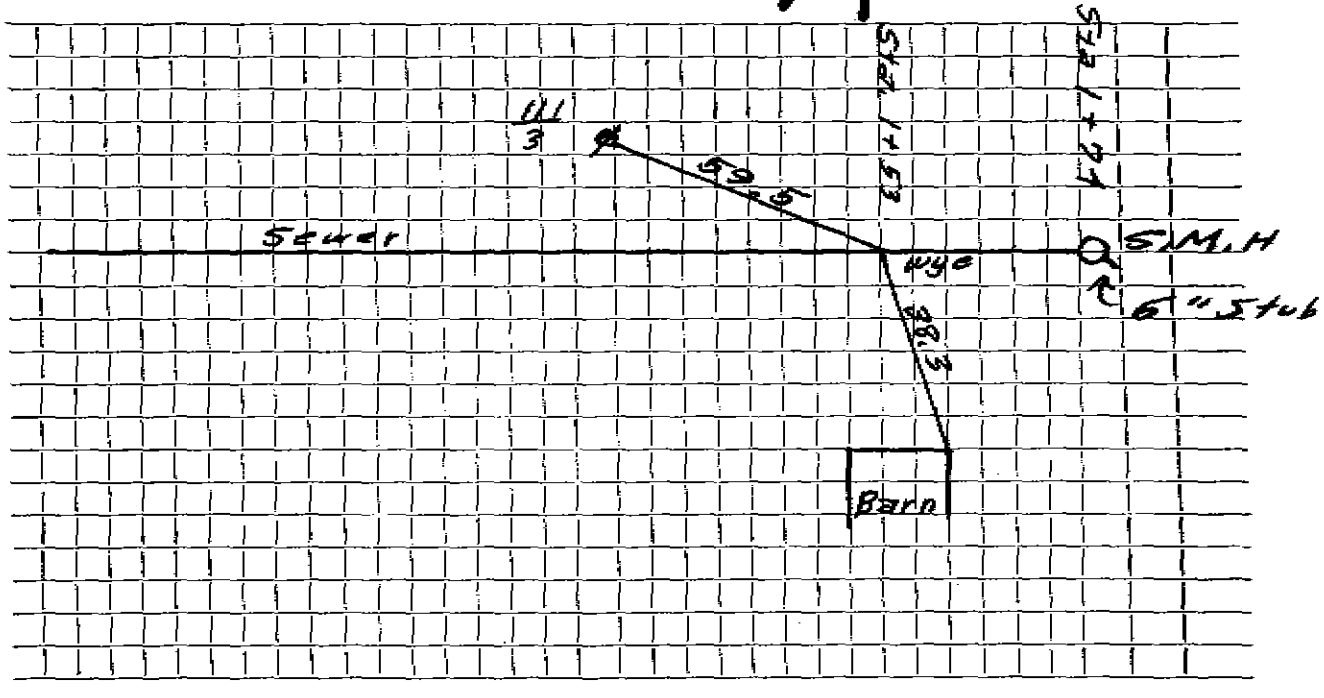

Connection made in ..... Street. Work completed .....

Remarks: .....

.....

.....