Name WOODHAVEN REALTY TRUST **Service No.**

Address 80 WESTVIEW STREET

Location

Kind of Pipe P.V.C **Size** 6" **Size of Main**

Repair ~~Renewal~~ ~~New Service~~ **Location**

Date		Material	Amount	Total	Date		Amount
MAY 7	78	16' 6" PVC					
"	"	1 45° BEND					
					9-7-04	MAIN Blocked in MH 130' Down from MH in yard Paper get caught	

DATE MAY 7 1998

TOWN OF LEXINGTON — BOARD OF PUBLIC WORKS

SEWER DIVISION

Sketch of Service Here

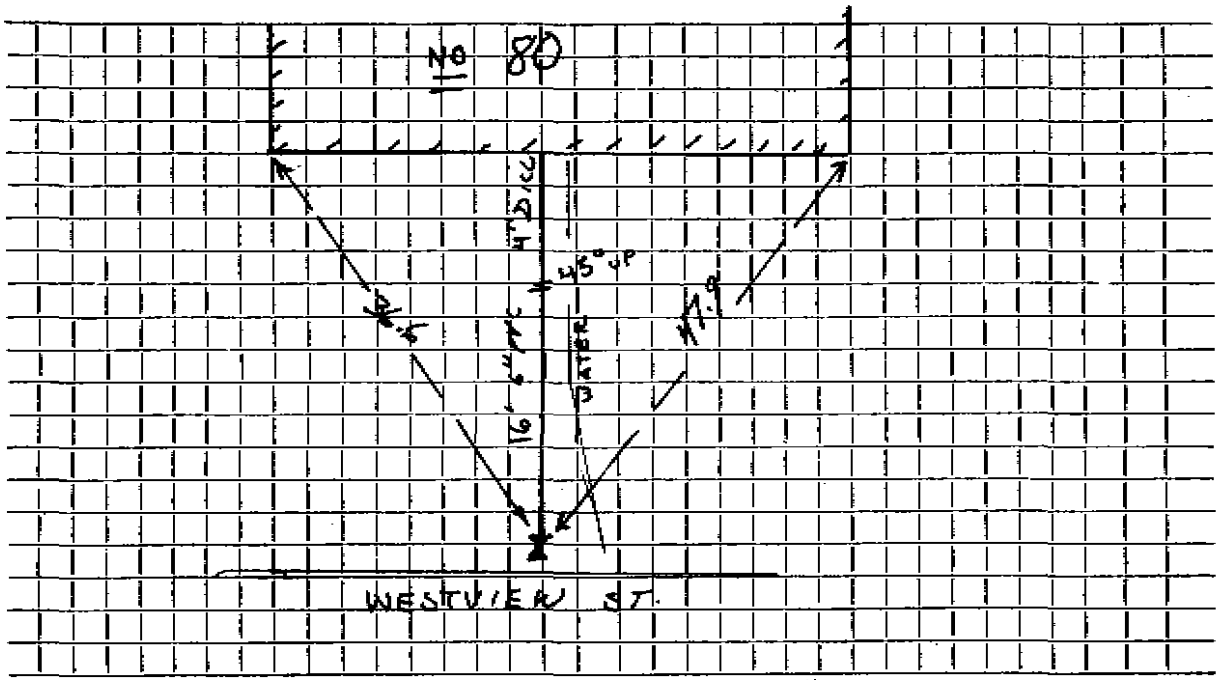

Connection made in WESTVIEW STREET Street. Work completed J.M. MCLAUGHLIN

Remarks: FIELD BOOK 98-2 SEE MAP IN DRAW WITH TYE CARDS

TJM