Name Joseph A. Bedard Service No.

Address 11 Westwood Road

11 Westwood Road Location

Kind of Pipe Size 6" Size of Main 8"

~~[illegible]~~—New Service Arlex 011 #3739 Location

Date		Material	Amount	Total	Date		Amount
1967		No Charge Easement					
8/10/82	102'	6" P.V.C.					
	15'	4" Iron					
	3	6" Wye					
	2	45° Elbow					
	3	22° Bends					
	2	4 x 6" Donuts					
	1	AC to PVC Adaptor					
		Clean Out Cap					

DATE _____

TOWN OF LEXINGTON — BOARD OF PUBLIC WORKS

SEWER DIVISION

Sketch of Service Here

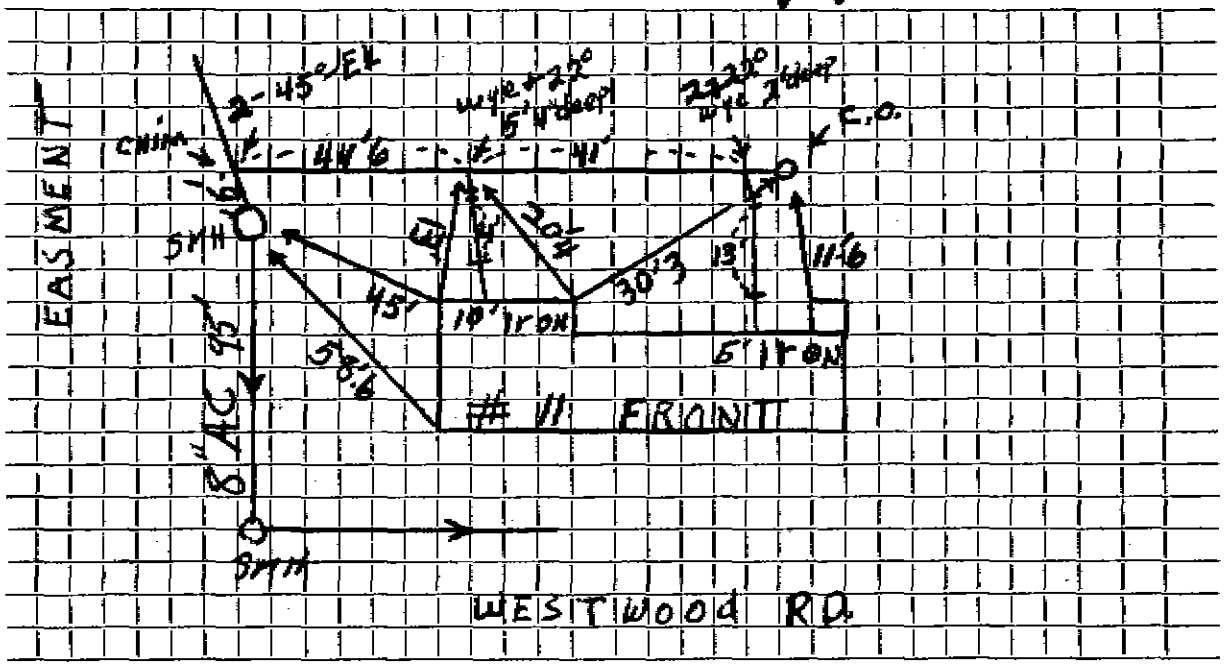

Connection made in ..... Street. Work completed .....

Remarks: .....

.....

.....