Name DeVries Const. Co. Service No.

Address 12 Wheeler Rd.

12 Wheeler Road Location

Kind of Pipe Size 6" Size of Main 8"

~~Repair, Renewal~~ New Service Location

Date	Material	Amount	Total	Date		Amount
1954	INSTALLED BY DEVELOPER					
	62'					
	Labor			10-30-98	AT	Respond + Measure

HP-6411

TOWN OF LEXINGTON—DEPT. OF PUBLIC WORKS

SEWER DIVISION

DATE ..... NO. .....

The undersigned applies for the construction of a particular sewer connecting No. ..... Street and hereby agrees to comply with the *Rules and Regulations governing* the construction and use of Particular Sewers, as now or at any future time established by the Board of Selectmen.

Am't of estimate $.....

Am't Paid $.....

..... Owner

Sketch of Service Here

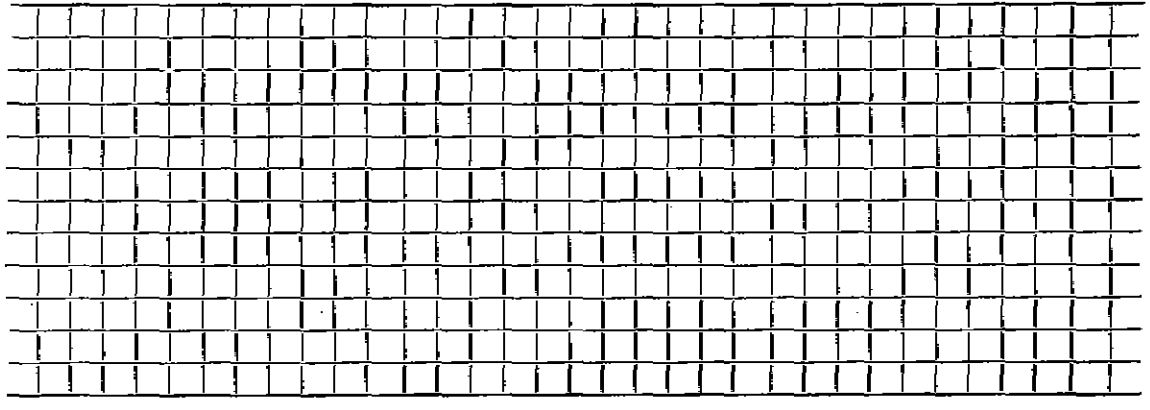

Connection made in ..... Street. Work completed ..... 19..

Remarks: