Name

Service No.

Address 16 Wheeler Rd

16 Wheeler Road

Location

Kind of Pipe

Size 6"

Size of Main 8"

Repair—Renewal—New Service

Location

Date	Material	Amount	Total	Date		Amount
7-2-96	3- 45° 6" PVC BENDS					
	1- 6"x6" PVC to CLAY FERNCO					
	50' 6" PVC Pipe					

DATE _____

TOWN OF LEXINGTON — BOARD OF PUBLIC WORKS

SEWER DIVISION

Sketch of Service Here

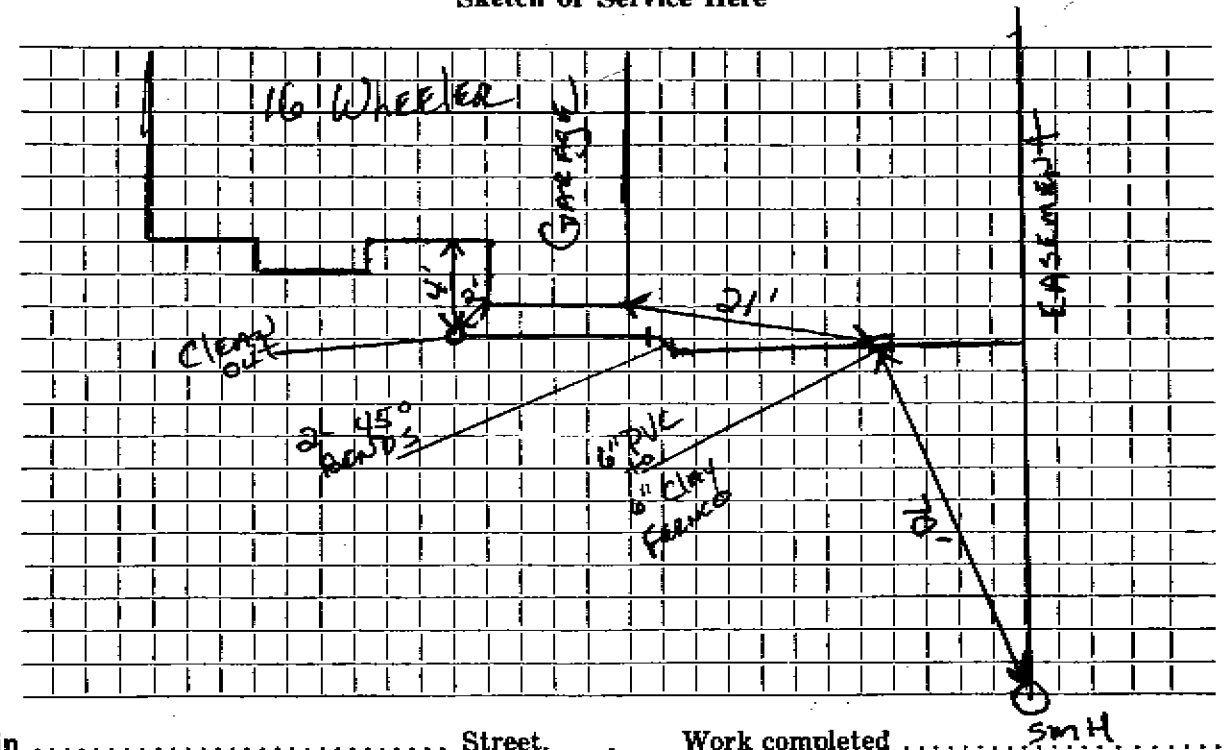

Connection made in ..... Street. Work completed .....

Remarks: BENDS GO IN DOWNWARD DIRECTION