Name DeVries Construction Co., Inc. Service No.

Address 17 Whipple Road

17 Whipple Road Location

Kind of Pipe Size 6" Size of Main 8"

Repair—Renewal—New Service Installed by developer Location

Date	Material	Amount	Total	Date		Amount
5/6/55						
	Labor					

HP-9694

TOWN OF LEXINGTON—DEPT. OF PUBLIC WORKS
SEWER DIVISION

DATE..... NO. .....

The undersigned applies for the construction of a particular sewer connecting No..... Street and hereby agrees to comply with the Rules and Regulations governing the construction and use of Particular Sewers, as now or at any future time established by the Board of Selectmen.

Am't of estimate $.....

Am't Paid $.....

..... Owner

Sketch of Service Here

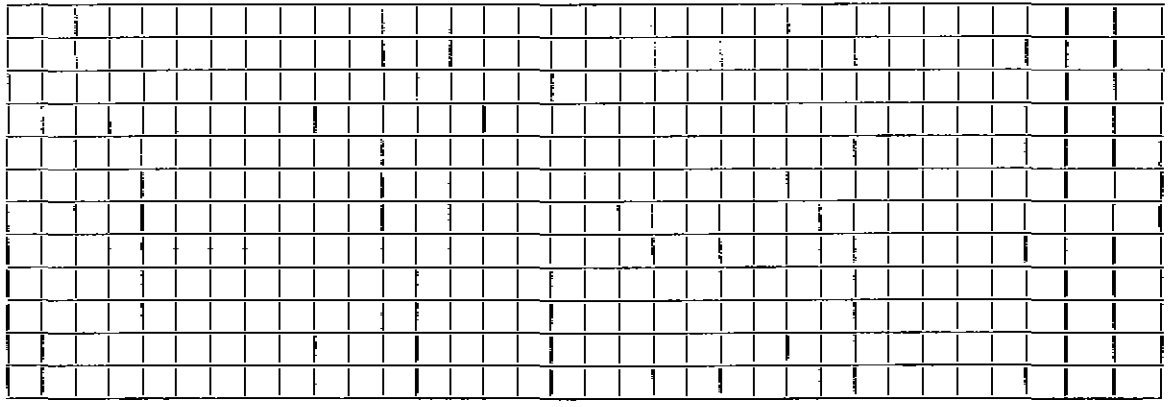

Connection made in..... Street. Work completed.....19..

Remarks: