Name DeVries Construction Company, Incorporated **Service No.**

Address 19 Whipple Road

19 Whipple Road **Location**

Kind of Pipe **Size** 6" **Size of Main** 8"

Repair—Renewal—New Service Installed by developer **Location**

Date	Material	Amount	Total	Date		Amount
5/6/55						
	Labor					

HP-9694

TOWN OF LEXINGTON—DEPT. OF PUBLIC WORKS

SEWER DIVISION

DATE..... NO. .....

The undersigned applies for the construction of a particular sewer connecting No..... Street and hereby agrees to comply with the Rules and Regulations governing the construction and use of Particular Sewers, as now or at any future time established by the Board of Selectmen.

Am't of estimate $.....

Am't Paid $.....

..... Owner

Sketch of Service Here

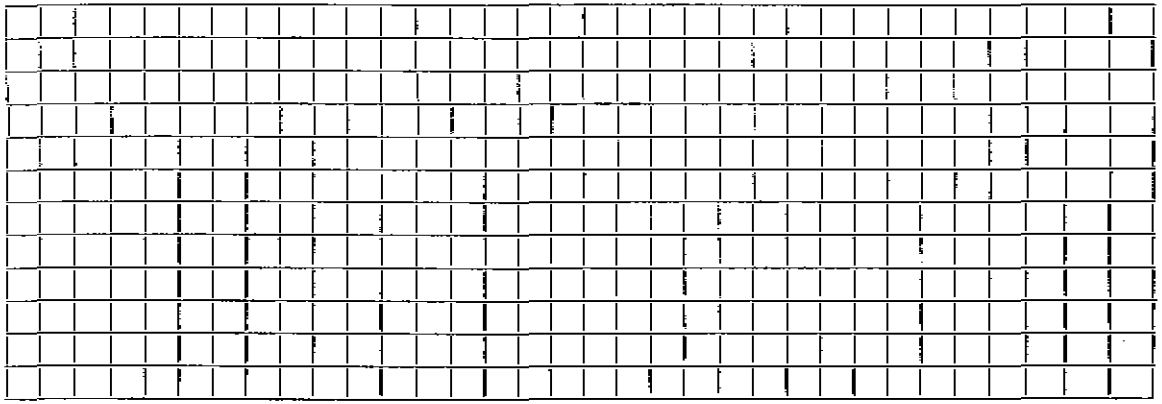

Connection made in..... Street. Work completed.....19..

Remarks: