Name | Service No.

Address 4 Whitman Circle

4 Whitman Circle | Location Lot #53

Kind of Pipe | Size 6" | Size of Main 8"

~~XXXXXXXXXXXX~~ New Service | Location

Date		Material	Amount		Total		Date			Amount	
/25/69	65'	6" Transite Pipe @	9.00		$ 585	00					

B.M.18501

DATE _____

TOWN OF LEXINGTON — BOARD OF PUBLIC WORKS

SEWER DIVISION

Sketch of Service Here 4

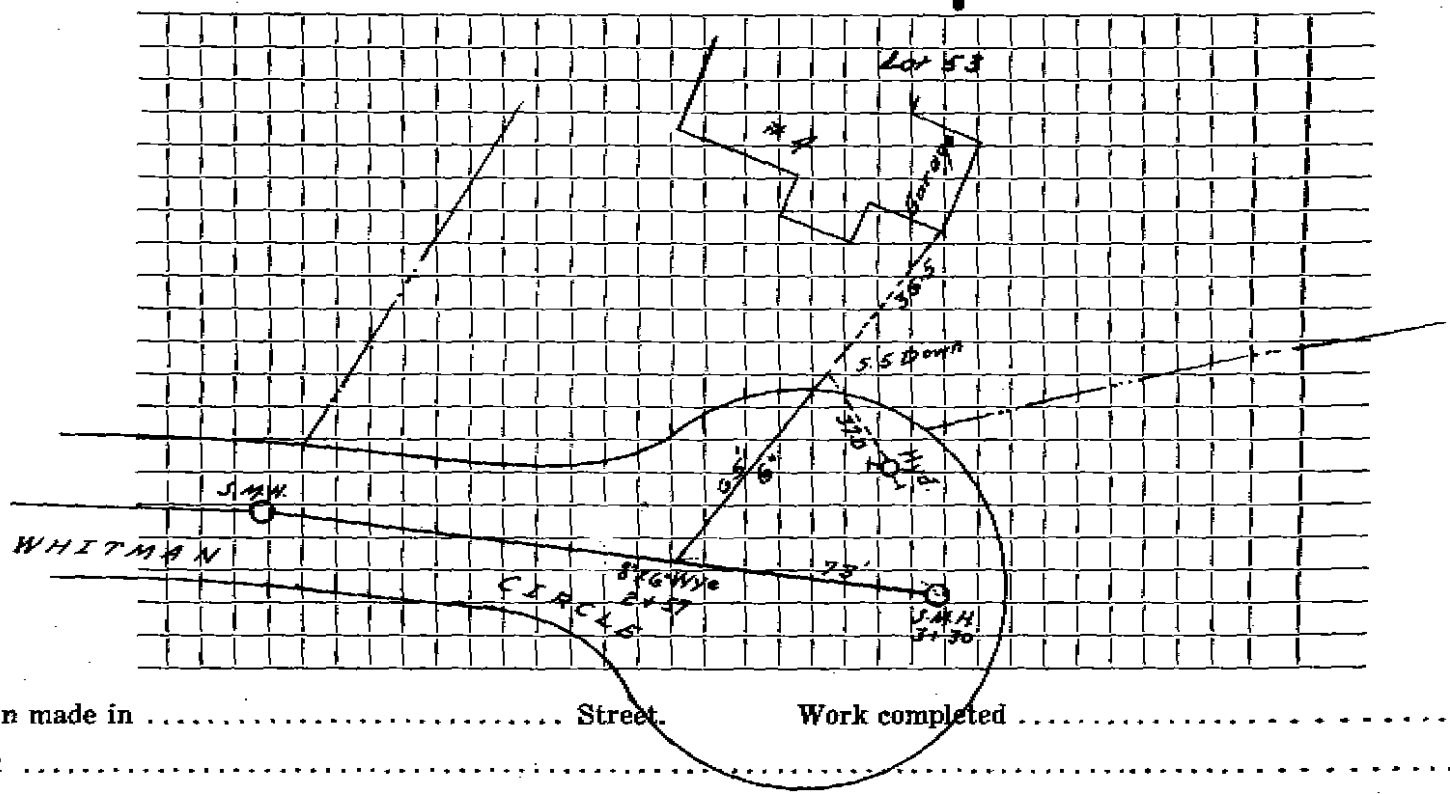

Connection made in ..... Street. Work completed .....

Remarks: .....

.....

.....