Name Helen C. Townsend **Service No.** 178

Address 5 WILSON RD

5 Wilson Road **Location**

Kind of Pipe **Size** 6" **Size of Main** 8"

Repair—Renewal—New Service W.O.# 7703 **Location** Comm 12-10-62

Date	Material	Amount	Total	Date		Amount
11-2-62	Labor	76.27		11-1-62	Deposit	200 00
	10% O.H.	7.63	83.90	12-10-62	Refund	28 23
54'	6" Transite Pipe @.82		44.28			171 77
1	90° Transite Elbow		4.09			
3	Hrs. Town Shovel @6.50		19.50			
2	Hrs. Trucking @3.00		6.00			
1	1X3 Patch		14.00			
			171.77			

DATE _____

TOWN OF LEXINGTON — BOARD OF PUBLIC WORKS

SEWER DIVISION

Sketch of Service Here 5

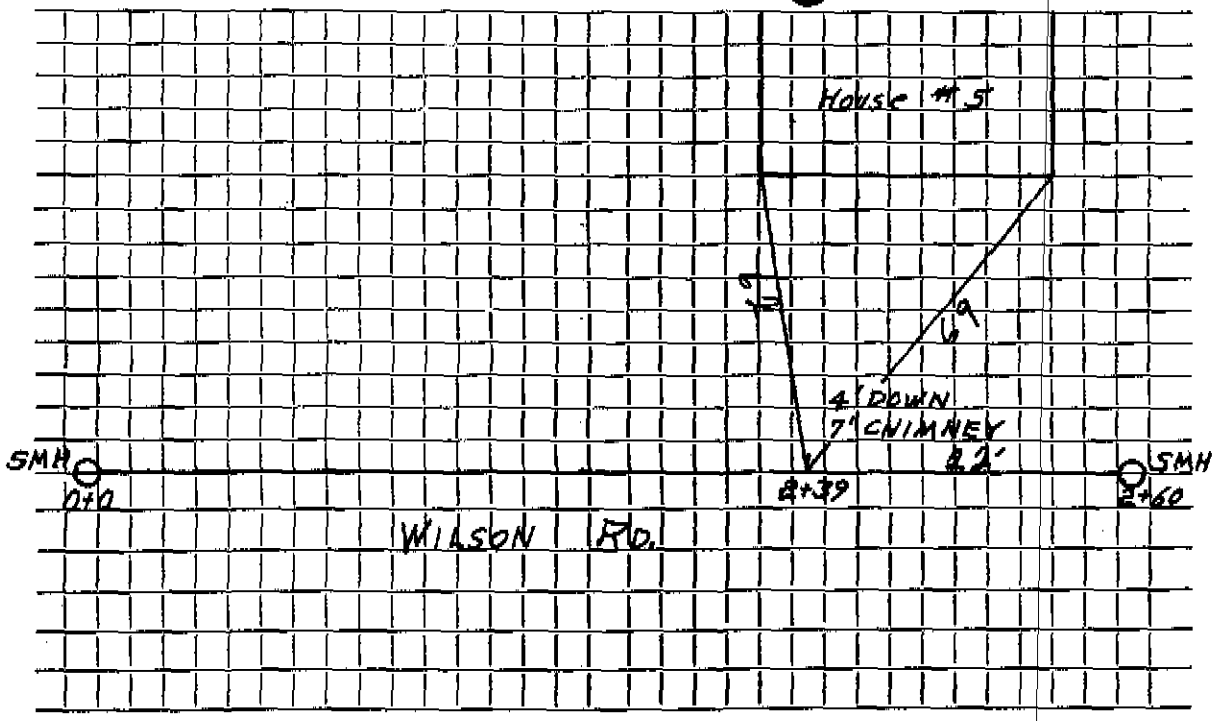

Connection made in ..... Street. Work completed .....

Remarks: .....

.....