Name William J. Abernathy

Service No. 104

Address #10 Wingate Rd.

Location

Kind of Pipe

Size 6" A.C.

Size of Main 8" A.C.

Repair—Renewal—New Service Valeri #3131

Location NOV 19 1973

Date		Material	Amount	Total	Date		Amount
9/12/72		24.0 L.F. @ 9.00	$216.00		9-5-73	Deposit	216 00
9/14/73	101	6" Transite pipe					

H.B.W.18501

DATE _____

TOWN OF LEXINGTON — BOARD OF PUBLIC WORKS

SEWER DIVISION

Sketch of Service Here

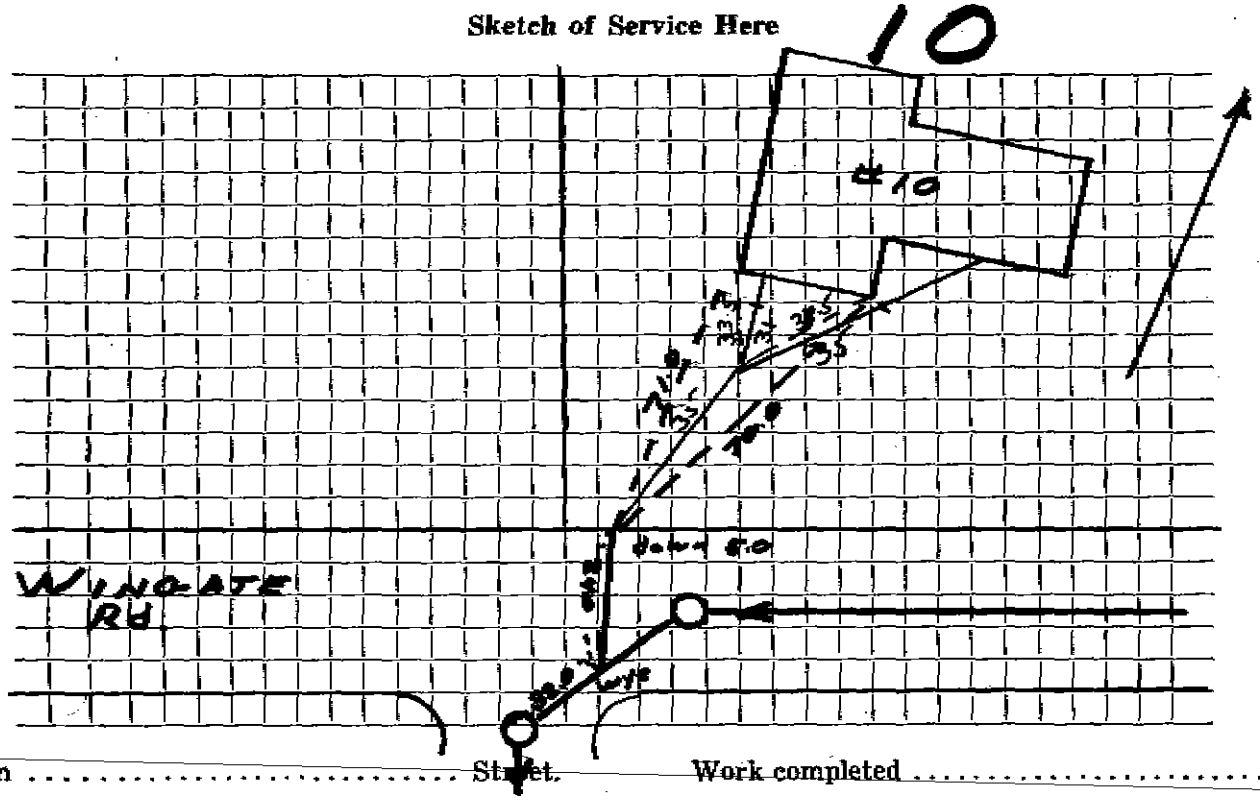

Connection made in ..... Street. Work completed .....

Remarks: .....

.....

.....