Name

Service No.

Address 49 Winter Street

49 Winter Street

Location

Kind of Pipe

Size 6"

Size of Main 8"

Repair—Renewal—New Service

Location

Date		Material	Amount		Total		Date			Amount	
August	66	13' @ $5.00	$65.	00							

H.B.K.1850R

DATE _____

TOWN OF LEXINGTON — BOARD OF PUBLIC WORKS

SEWER DIVISION

Sketch of Service Here 49

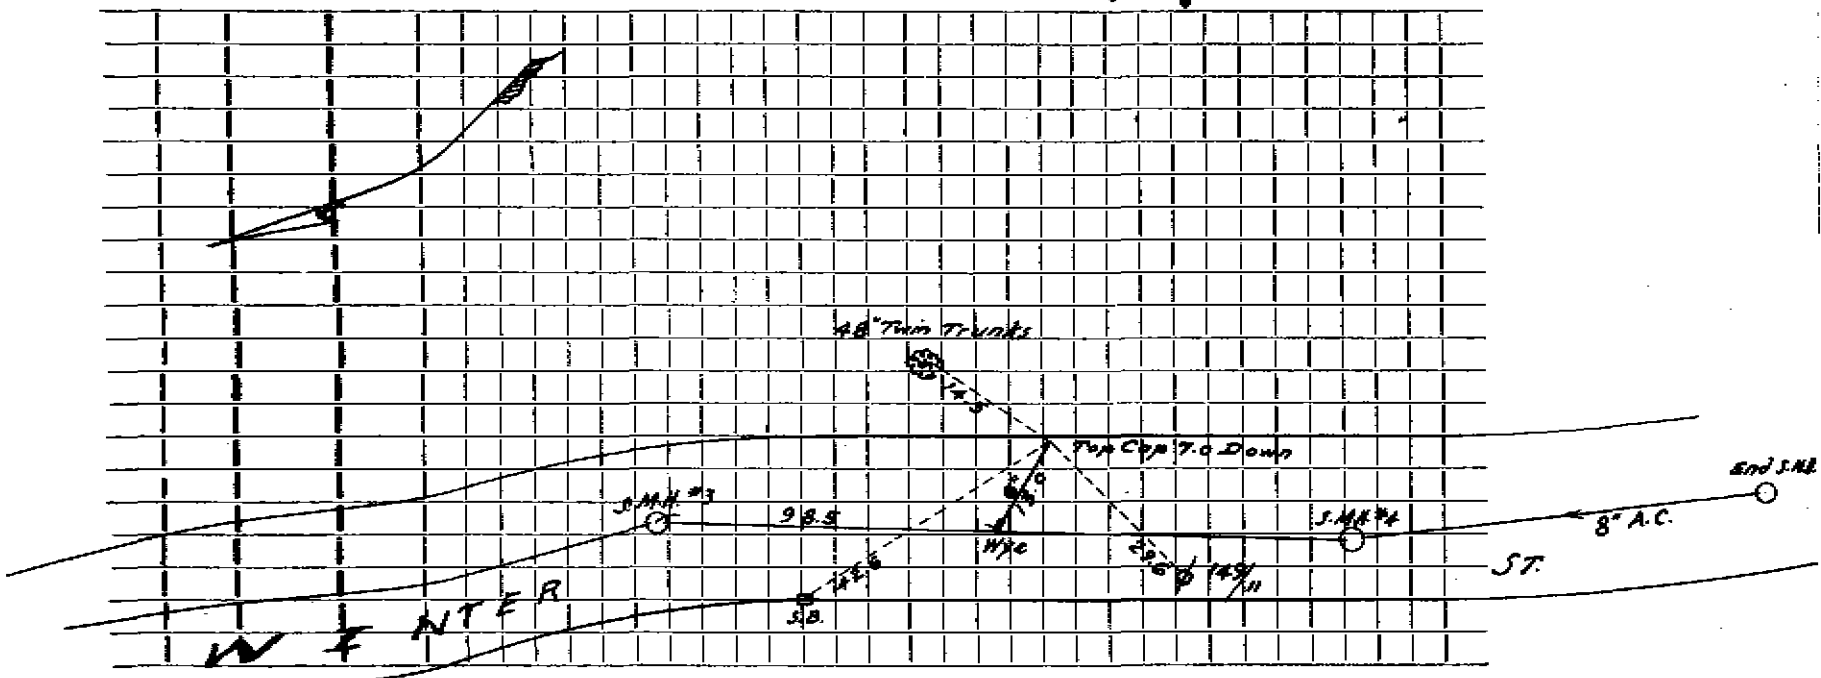

Connection made in ..... Street. Work completed .....

Remarks: .....

.....

.....