Name Karakin Kazanjian **Services No.** 24

Address 75 Winter Street

75 Winter Street **Location**

Kind of Pipe **Size** 6" **Size of Main** 8"

Repair—Renewal—New Service Iodice # 1011 **Location** AUG 5 1968

Date		Material	Amount		Total		Date		Amount	
							4-25-68	Deposit	110	00
August	66	22' @ $5.00	$110.	00						
6/4/68	10'	4" Cast Iron								
	20'	6" Transite								

H.B.M.18501

DATE _____

TOWN OF LEXINGTON — BOARD OF PUBLIC WORKS

SEWER DIVISION

Sketch of Service Here 75

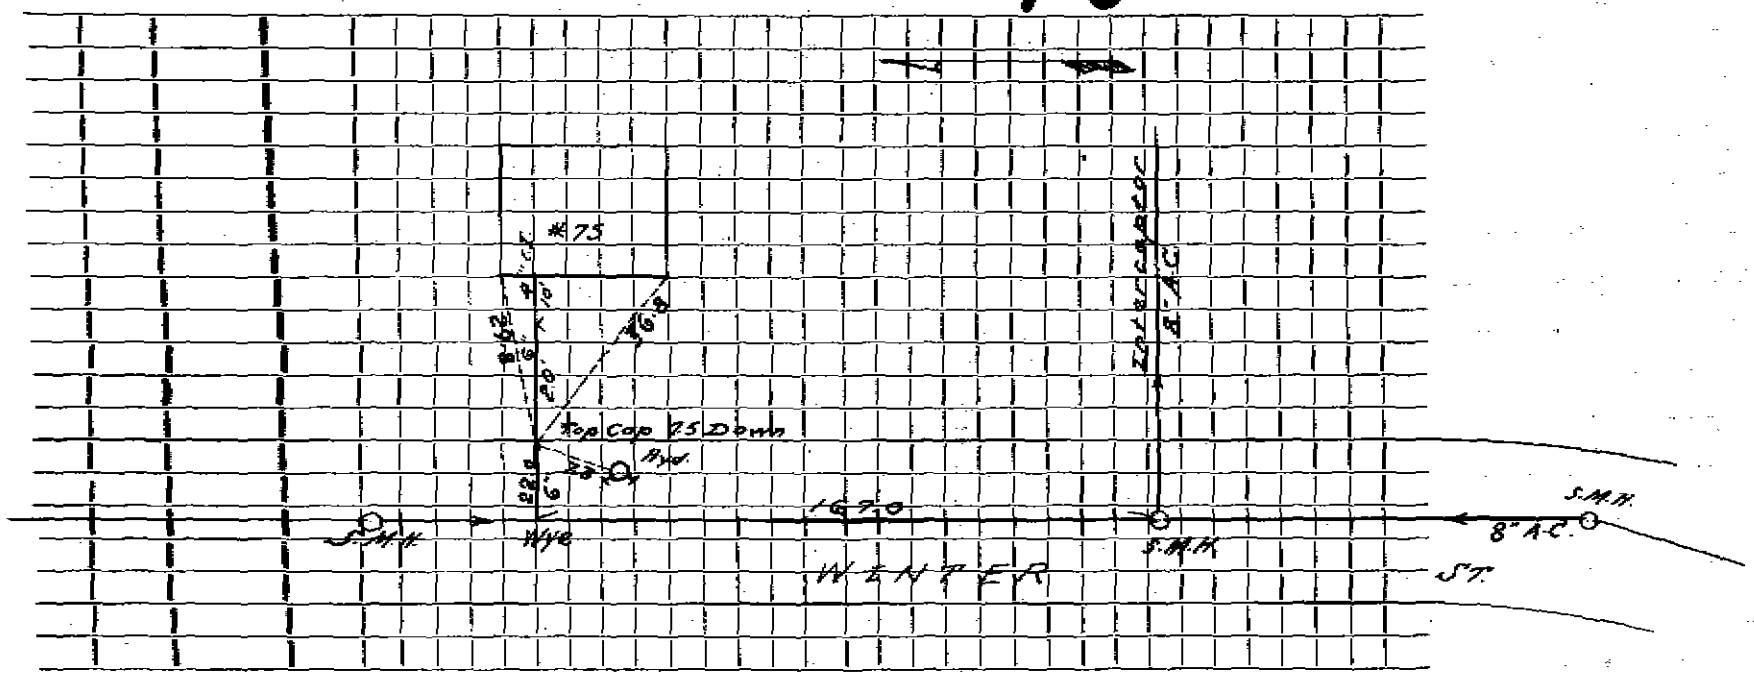

Connection made in ..... Street. Work completed .....

Remarks: .....

.....

.....