Name *Mr. Flynn* Service No.

Address ~~*108 Woburn Street*~~

108 Woburn STreeT Location

Kind of Pipe Size *6"* Size of Main *8"*

~~Repair Renewal~~ New Service *Redmond #4602* Location

Date		Material	Amount	Total	Date		Amount
9/30/86	*57'*	*6" P.V.C.*					
		6" Saddle Fernco on Saddle					
		90° Elbow					
		22° Bend					
		4 " x 6" Clay to PVC Fernco					
	1	*Wye Cleanout*					

DATE _____

TOWN OF LEXINGTON — BOARD OF PUBLIC WORKS

SEWER DIVISION

Sketch of Service Here 108

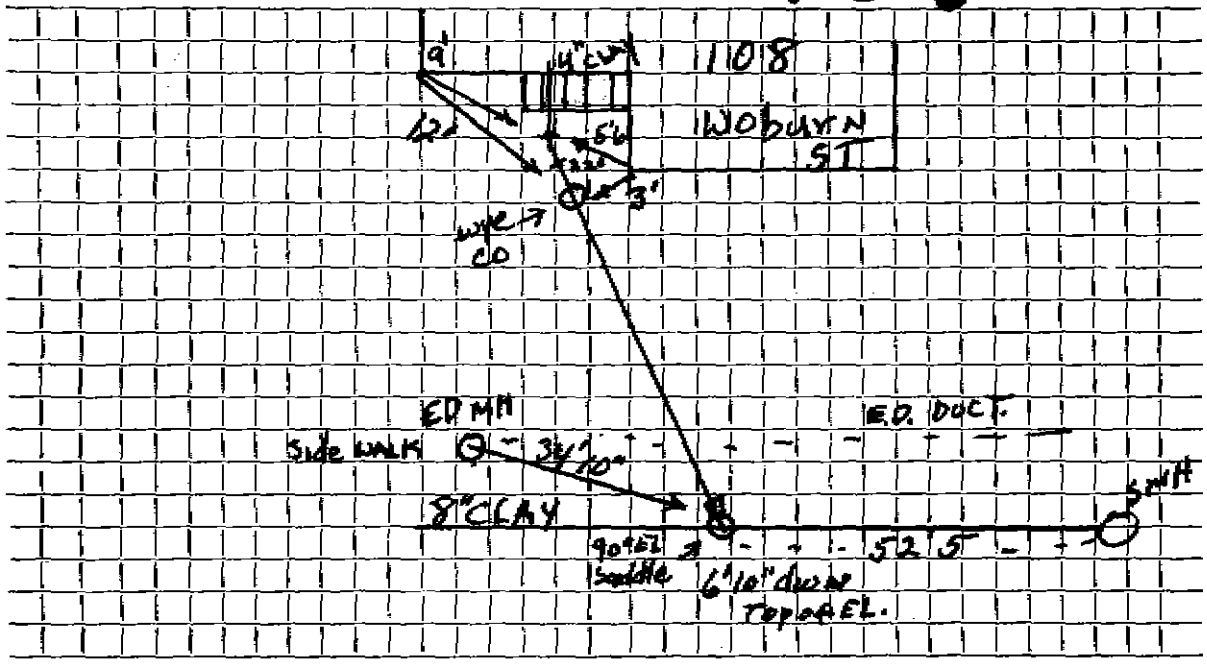

Connection made in ..... Street. Work completed .....

Remarks: .....

.....

.....