Name Joseph Fusco **Service No.** 42

Address 205-207 WOBURN ST

205-207 Woburn STreeT **Location**

Kind of Pipe ACP + PVC **Size** 6" **Size of Main** 8" ACP

~~Repair~~ ~~Renewal~~ New Service Valeri #4188 **Location** FEB 24 1986

Date		Material	Amount	Total	Date		Amount
5-24-73		26' OF 6" ACP @ 9.00	$234.00		11-8-85	Deposit	234.00
12/20/85	179'	x 6" P.V.C. Pipe					
	4	6" x Wye w/caps					
	3	6" x 22½° Elbow					
	1	6" x 45° Elbow					
	1	6" x 4" Donut					

DATE MAY 24, 1973

TOWN OF LEXINGTON — BOARD OF PUBLIC WORKS

SEWER DIVISION

Sketch of Service Here

205 + 207

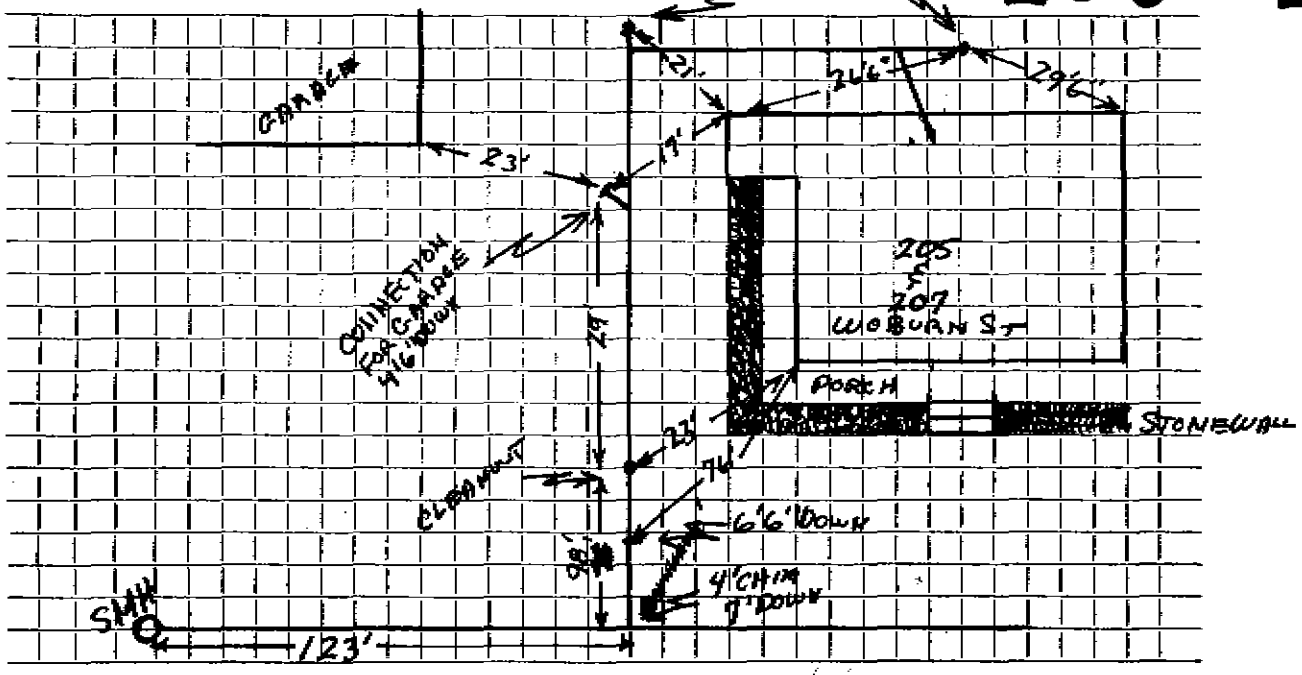

Connection made in WOBURN ST Street. Work completed DEC 20, 1985

Remarks: CONNECTION FOR GARAGE 100' IN FROM PROPERTY LINE