Name

Service No.

Address 265 WOBURN ST.

265 Woburn ST.

Location

Kind of Pipe

Size 6" A.C

Size of Main 8"

Repair—Renewal—New Service

Location

Date		Material	Amount	Total	Date			Amount
~~5-17-73~~		~~26' 6" AC @ $9.00~~	~~$234.00~~					
5-10-	95							
	130'	6" P.V.C.			5-17-	73		
	1	6"-22½° Bend				26'	6" Transite	
						1	6"X8" Wye	

F.S.N.18501

DATE _____

TOWN OF LEXINGTON — BOARD OF PUBLIC WORKS

SEWER DIVISION

Sketch of Service Here 265

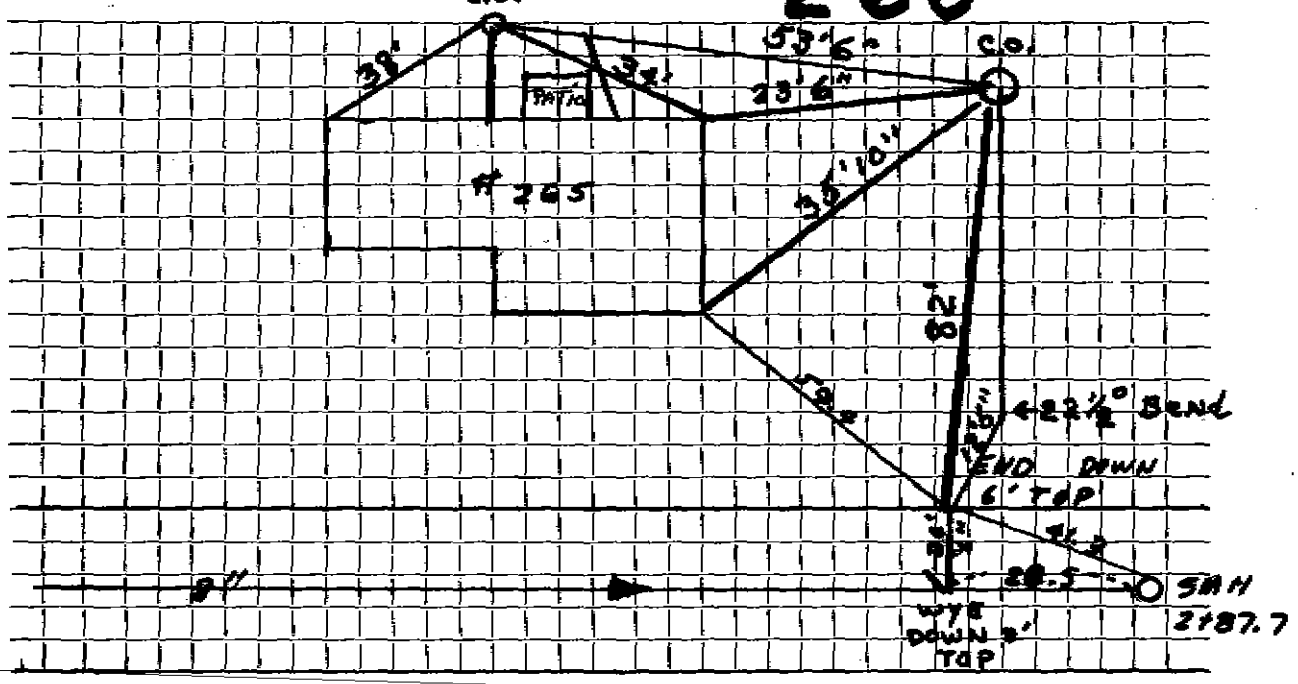

Connection made in ..... Street. Work completed .....

Remarks: .....

.....

.....