**Name** Edward J. Modoona **Service No.**

**Address** 279 WOBURN ST.

279 Woburn STreeT **Location**

**Kind of Pipe** PVC **Size** 6"&4" **Size of Main** 8"

**Repair—Renewal—New Service** #4657 Valeri Construction **Location**

| Date | | Material | Amount | | Total | | Date | | Amount | |
|---|---|---|---|---|---|---|---|---|---|---|
| 5/6/88 | | 10LF 4" PVC | | | | | [redacted] | | | |
| | | 21 LF 6" PVC | | | | | | | | |
| | | 2-6"X6" FERNCO'S | | | | | | | | |
| | | 4"X6" FERNCO | | | | | | | | |
| | | 6"X6" WYE | | | | | | | | |
| 10/2/74 | 30' | AC @ | $8.00 | ft. | $ 240 | 00 | 10/23/74 | Deposit | 240 | 00 |
| 10/24/74 | 114. | 5' 6" AC | | | | | | | | |
| | 6' | 4" C.I. Pipe | | | | | | | | |

DATE 6/8/88

# TOWN OF LEXINGTON — BOARD OF PUBLIC WORKS

## SEWER DIVISION

Sketch of Service Here 279

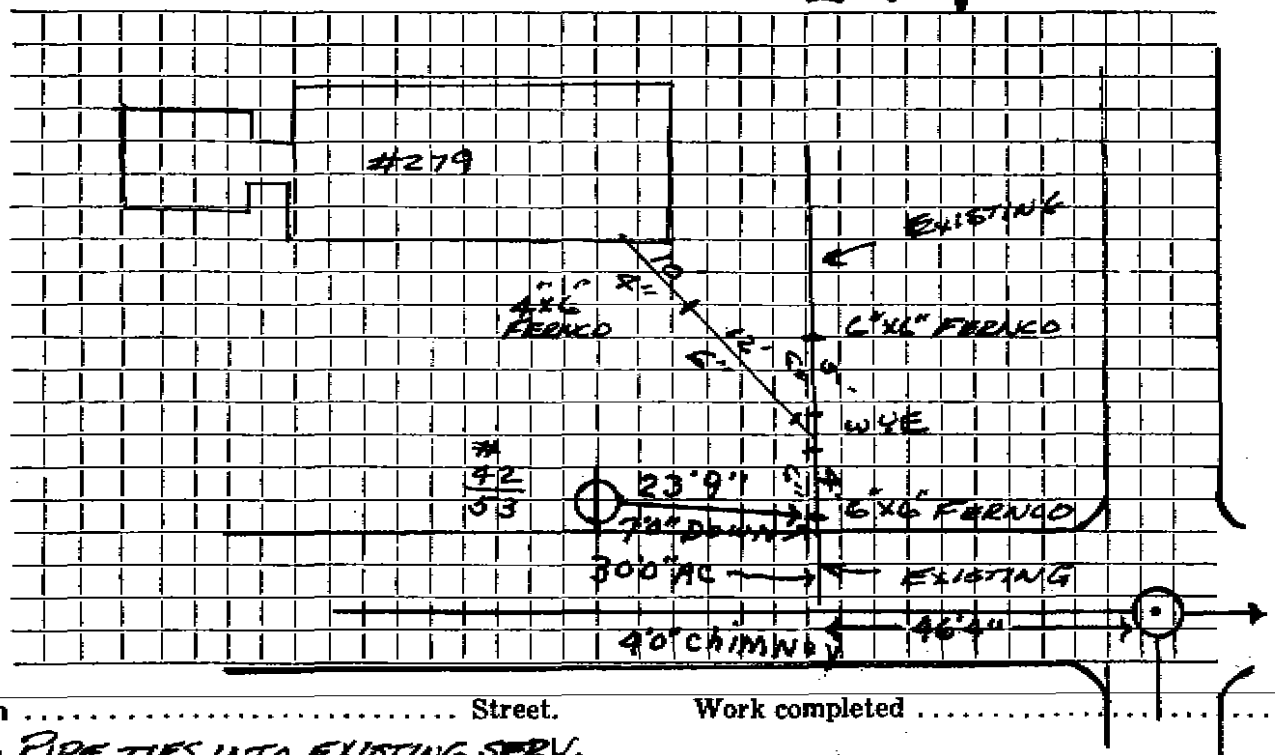


Connection made in ..... Street. Work completed .....

Remarks: NEW PIPE TIES INTO EXISTING SERV.