Name Elizabeth Barclay (Countryside) Service No. 57

Address 295 Woburn Street

295 Weburn STreeT Location

Kind of Pipe A.C. Size 6" Size of Main 8"

[redacted]-New Service Valeri #3603 Location OCT 6 1980

Date		Material	Amount	Total	Date		Amount
10-2-74	31'	A.C. pipe @ $8.00		248.00	9-26-80	Deposit	248.00
10-20-80	254'	8" A.C. Pipe MAIN					
	3	Man Holes					
	2	30° Bends					
	1	22° Bend					
		6 SERVICES					
	3	6" A.C. to 4" Cast.					
	3	6"A.C. to 3" Cast.					

DATE _____

TOWN OF LEXINGTON — BOARD OF PUBLIC WORKS

SEWER DIVISION

Sketch of Service Here

295

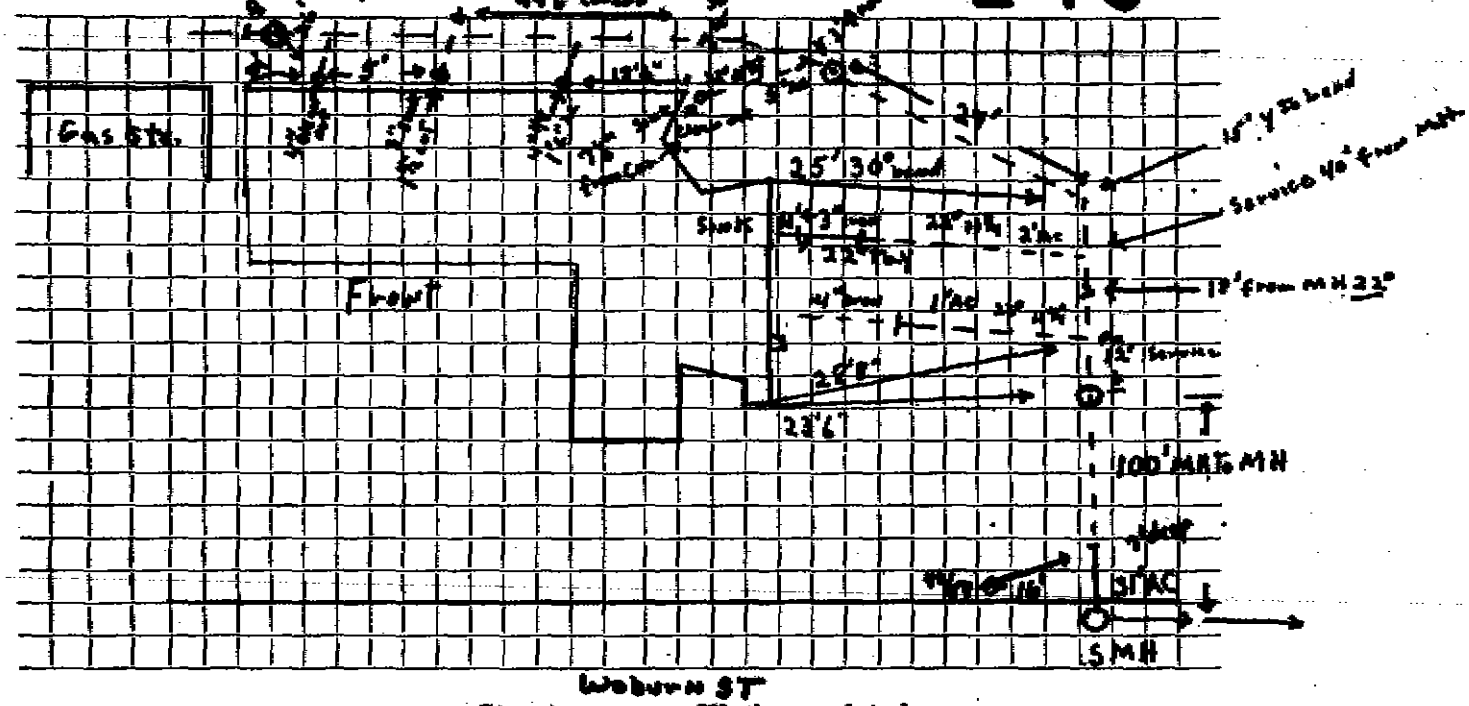

Connection made in ..... Street. Work completed .....

Remarks: .....

.....

.....