Name Donald E. Sicco **Service No.** 50

Address 364 Woburn Street

Lot 7 364 Woburn STreet **Location** Lot

Kind of Pipe **Size** 6" **Size of Main** 8"

Repair—Renewal—New Service Valeri #1617 **Location** JUL 27 1970

Date		Material	Amount	Total	Date		Amount
1970	30'	6" Transite pipe @9.00		270.00	6-26-70	Deposit	270 00
7-9-70	16'	6" Transite pipe					
	16'	4" Cast Iron pipe					

H.B.K.18501

DATE

TOWN OF LEXINGTON — BOARD OF PUBLIC WORKS

SEWER DIVISION

Sketch of Service Here

364

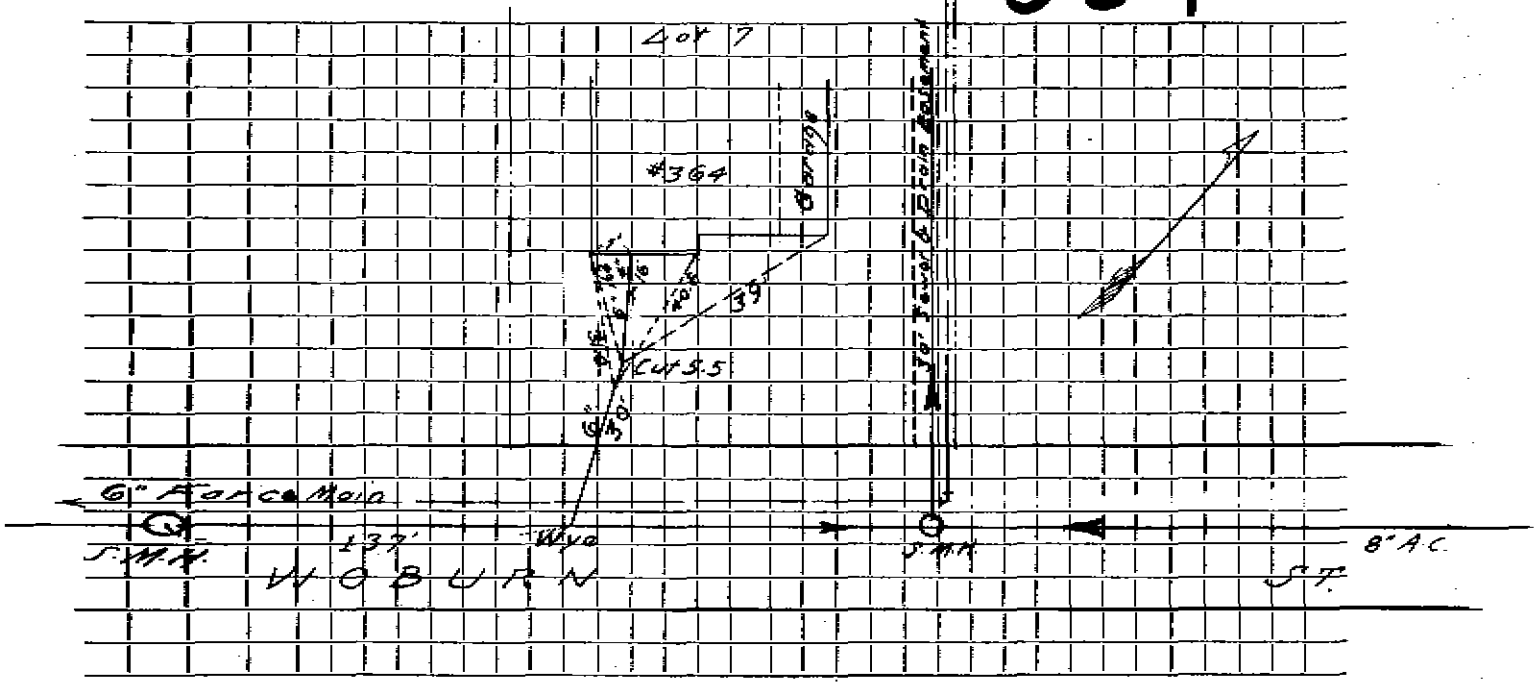

Connection made in ..... Street. Work completed .....

Remarks: .....

.....

.....