Name Tocci Service No.

Address 378 Woburn St

Location

Kind of Pipe SDR 35 PVC Size 6" Size of Main

Repair—Renewal—New Service Location

Date	Material	Amount	Total	Date		Amount
11/19/20	6" PVC pipe					
	6" Fernco					
	6" cleanout					

DATE 11/19/2020

TOWN OF LEXINGTON — BOARD OF PUBLIC WORKS

SEWER DIVISION

Sketch of Service Here

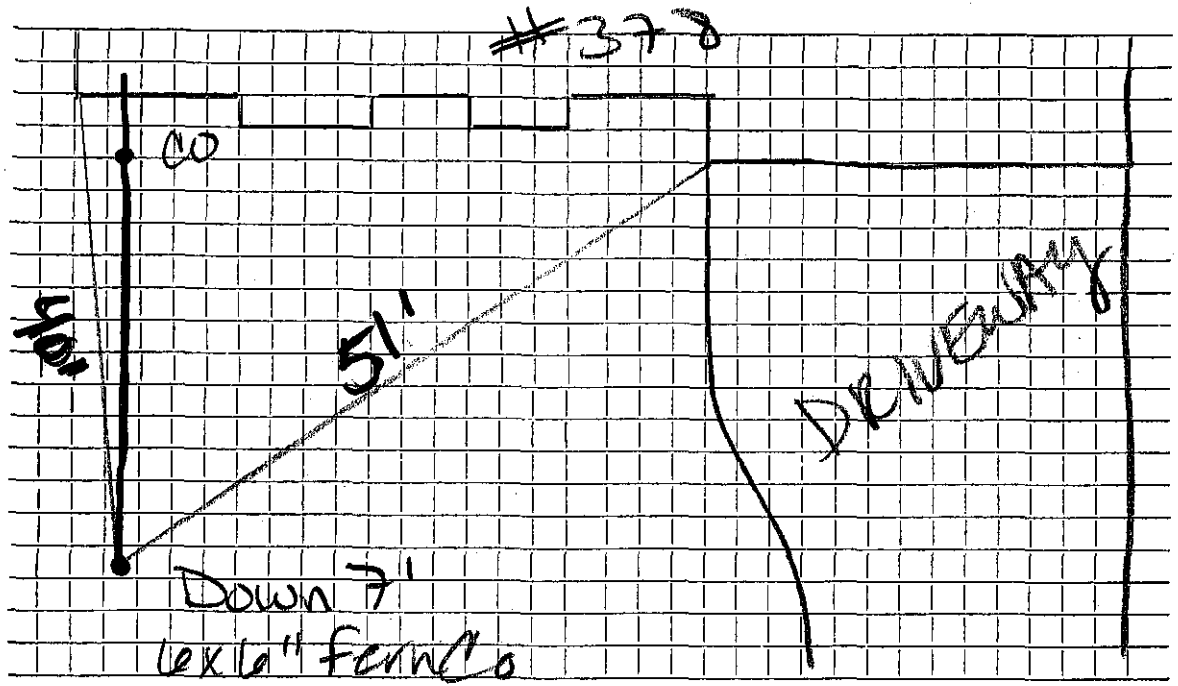

Connection made in ....Woburn..... Street. Work completed .....

Remarks: .....

.....

....