Name Robert Lawler **Service No.**

Address 390 Woburn Street

Lot 2 390 Woburn STreeT **Location**

Kind of Pipe **Size** 6" **Size of Main** 8"

Repair—Renewal—New Service **Location**

Date		Material	Amount		Total		Date			Amount	
1970	30'	6" Transite pipe @9	.00		270	00					
		[redacted]									
11/20	88	8' CI FERNCO									
		40' of 6" PVC									

K.S.M.18501

DATE

TOWN OF LEXINGTON — BOARD OF PUBLIC WORKS

SEWER DIVISION

Sketch of Service Here 390

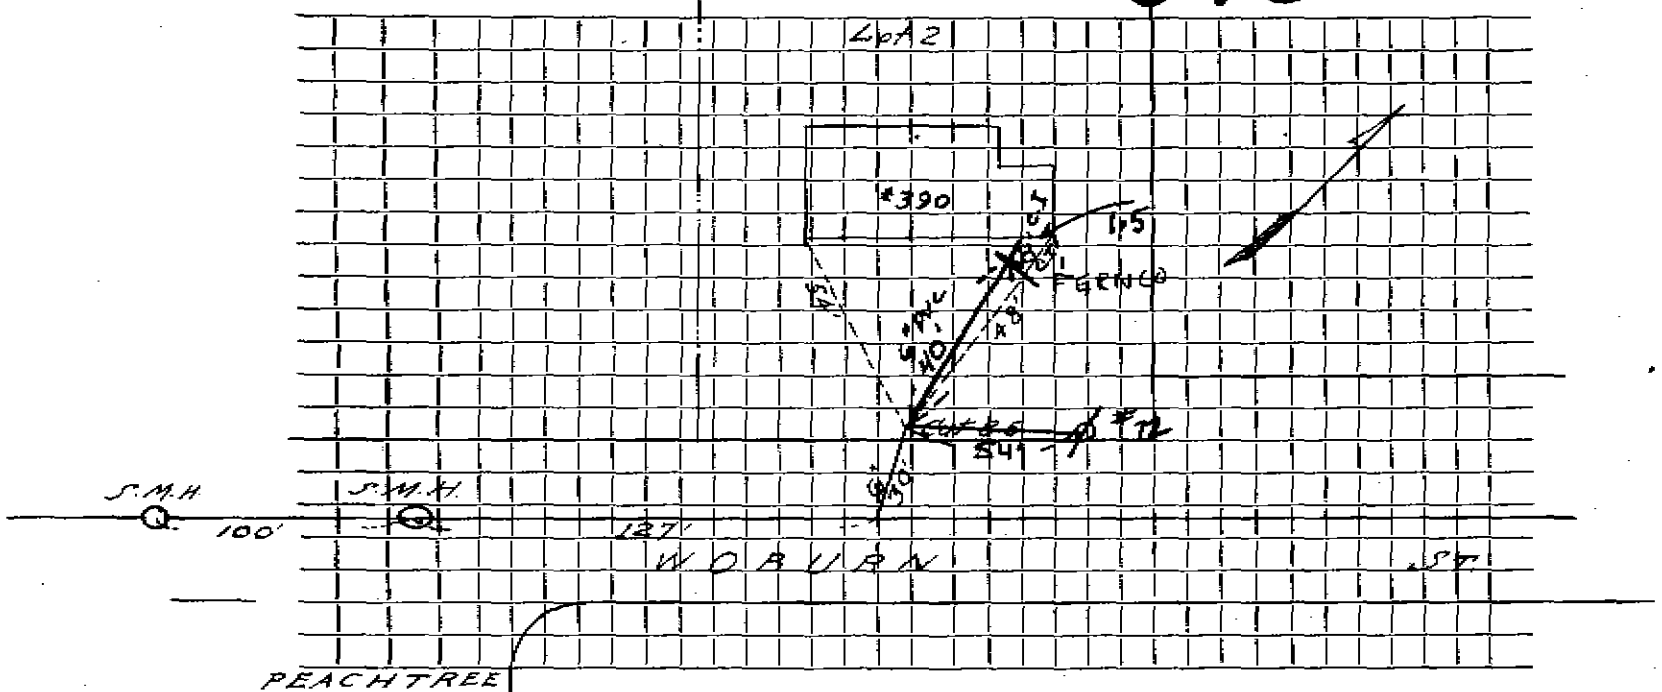

Connection made in RD. Street. Work completed

Remarks: