Name Robert Phalen **Service No.**

Address 100 Wood Street

100 Wood STreeT **Location**

Kind of Pipe **Size** 6" **Size of Main** 8"

~~Repair~~ ~~Renewal~~ **New Service** Redmond #4437 **Location**

Date		Material	Amount	Total	Date			Amount
10/1/87	49'	6" PVC						
	5'6"	4" PVC						
	1	4" x 6" Fernco						
							OUTSIDE	
					10/1/87	26'	6" PVC	
						1	90° Elbow	
						1	6" x 8" Saddle	

DATE _____

TOWN OF LEXINGTON — BOARD OF PUBLIC WORKS

SEWER DIVISION

Sketch of Service Here 100

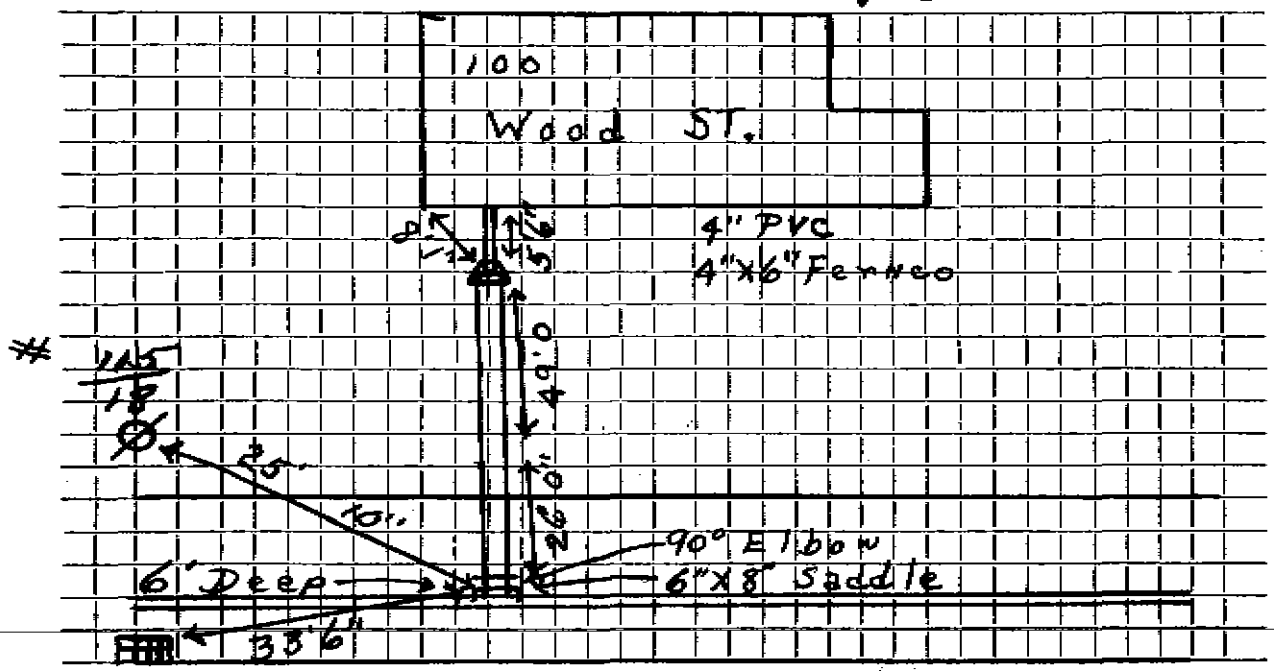

Connection made in ..... Street. Work completed .....

Remarks: .....

.....