Name William Kennedy

Service No. 34 (76)

Address 135 Wood St.

135 Wood STreeT

Location

Kind of Pipe AC.

Size 6"

Size of Main 8"

Repair—Renewal—New Service

Ralph Surianello #2833

Location

AUG 16 1976

Date		Material	Amount		Total		Date			Amount	
11-26-75		24'-6" ACP @	5.75	+	$138.	00	6/1/76		Deposit	138	00
6/24/76	74'	6" Transite Pipe									

DATE 4-25-75

TOWN OF LEXINGTON — BOARD OF PUBLIC WORKS

SEWER DIVISION

135 Sketch of Service Here

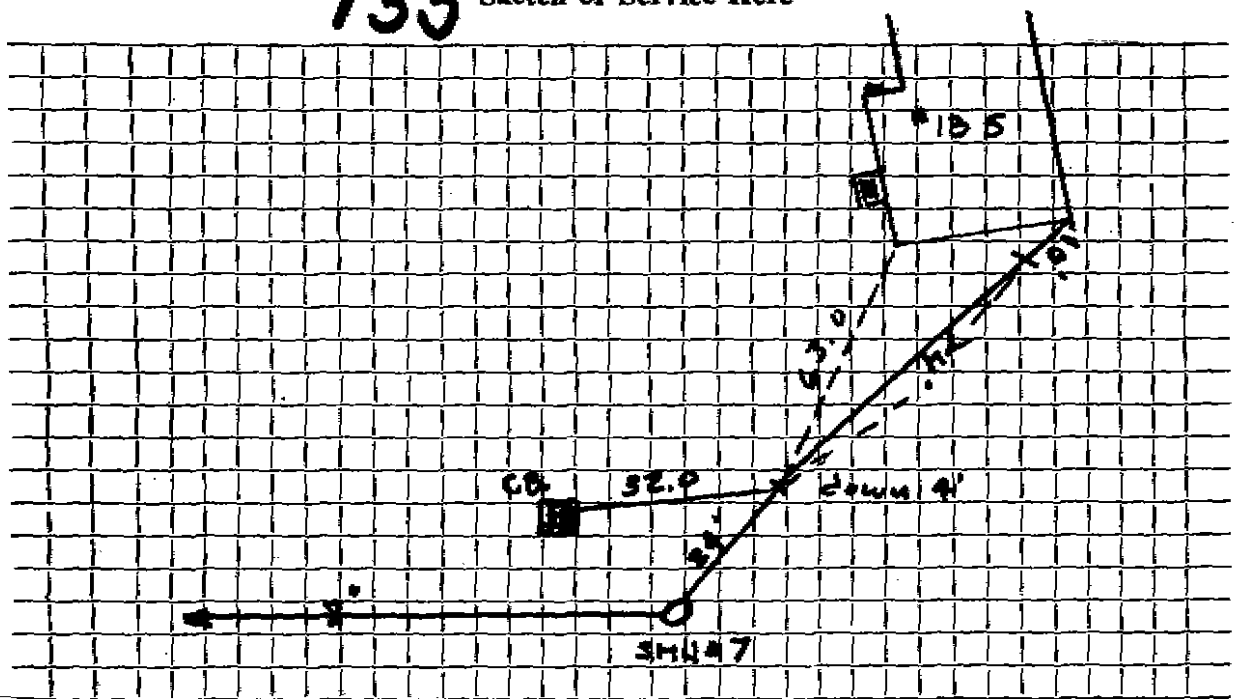

Connection made in 135 Wood St. Street. Work completed 6/24/76

Remarks: Service out of smh - up 5' from invert