Name Service No.

Address 50 Wood Street

Location

Kind of Pipe Size Size of Main

Repair—Renewal—New Service Location

Date	Material	Amount	Total	Date		Amount

DATE _____

TOWN OF LEXINGTON — BOARD OF PUBLIC WORKS

SEWER DIVISION

Sketch of Service Here

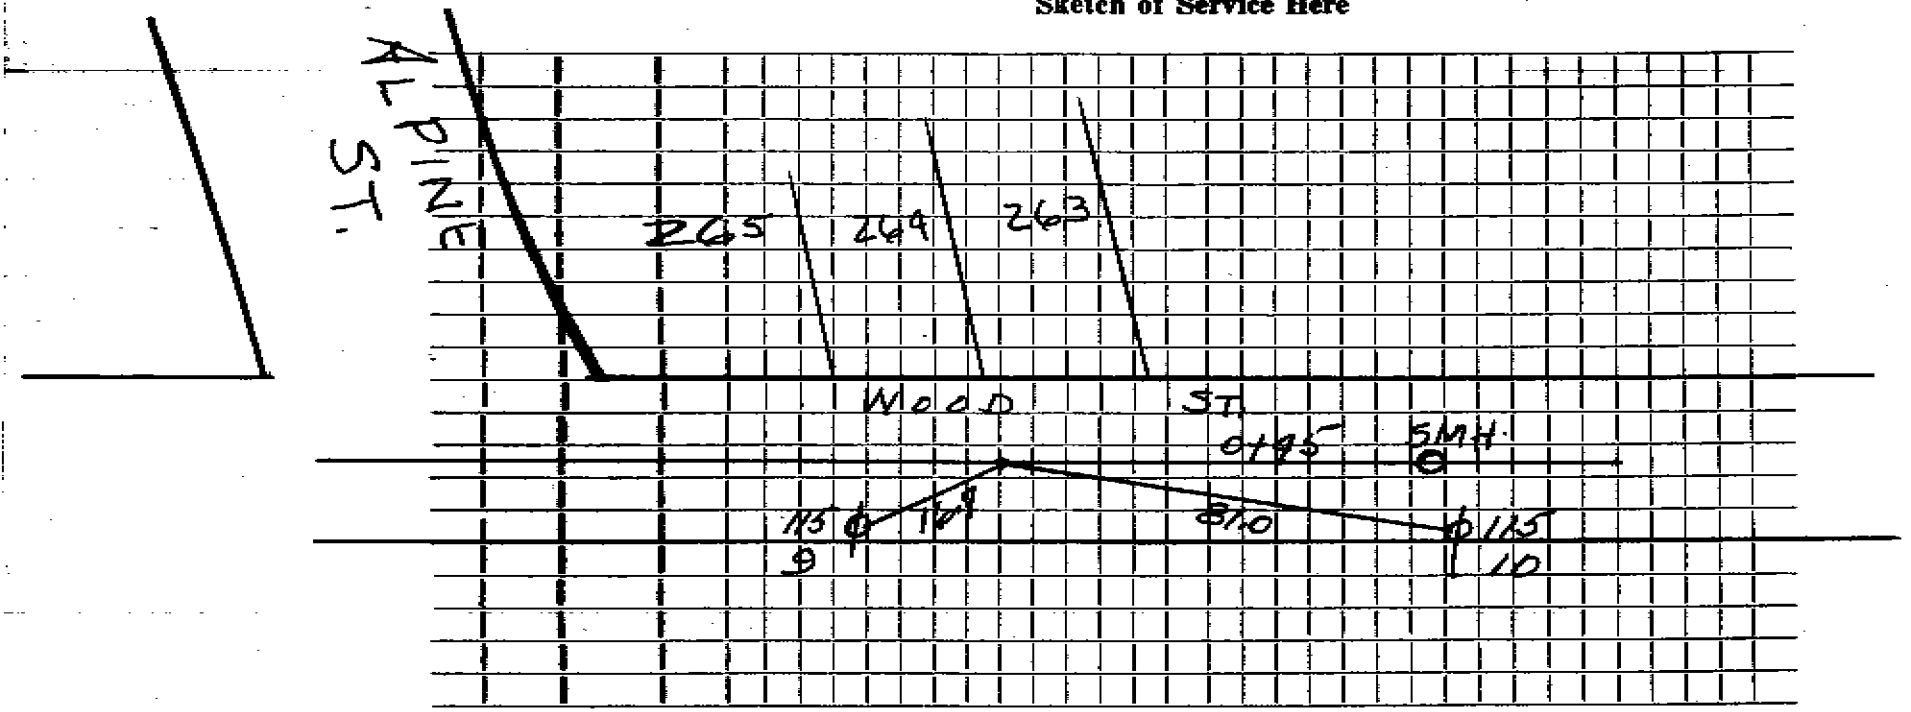

Connection made in ..... **Street.** **Work completed** .....

Remarks: .....

.....

.....

Name L. H. Hewett Jr., Inc. **Service No.** 89

Address 50 Wood Street

50 Wood STreeT **Location**

Kind of Pipe **Size** 6" **Size of Main** 8"

[redacted] **New Service** **Location**

JUL 7 1980

Date		Material	Amount	Total	Date			Amount
12-4-79		Labor	178.15		10-31-79		Deposit	600 00
		10% O.H.	17.82	195.97	7-7-80	X	Refund	147 28
	20'	6" Transite @1.62		32.40				452 72
	1	6" x 90° Transite Elbow		9.28				
	1	6" x 11¼° Transite Bend		9.52				
	1	6" x 5' Nipple @2.09		10.45				
	1	6" Plug		2.95				
	½	bag Cement		1.15				
	3	hrs. Trucking @3.00		9.00				
	4	hrs. Backhoe @6.50		26.00				
		Hot Top 9' x 26'		156.00				
				452.72				
12-28-79	191'	6" Transite pipe						
	20'	4" Cast Iron pipe						
						X	Apply 92.93 to SH C#90	9/

DATE _____

TOWN OF LEXINGTON — BOARD OF PUBLIC WORKS

SEWER DIVISION

Sketch of Service Here 50

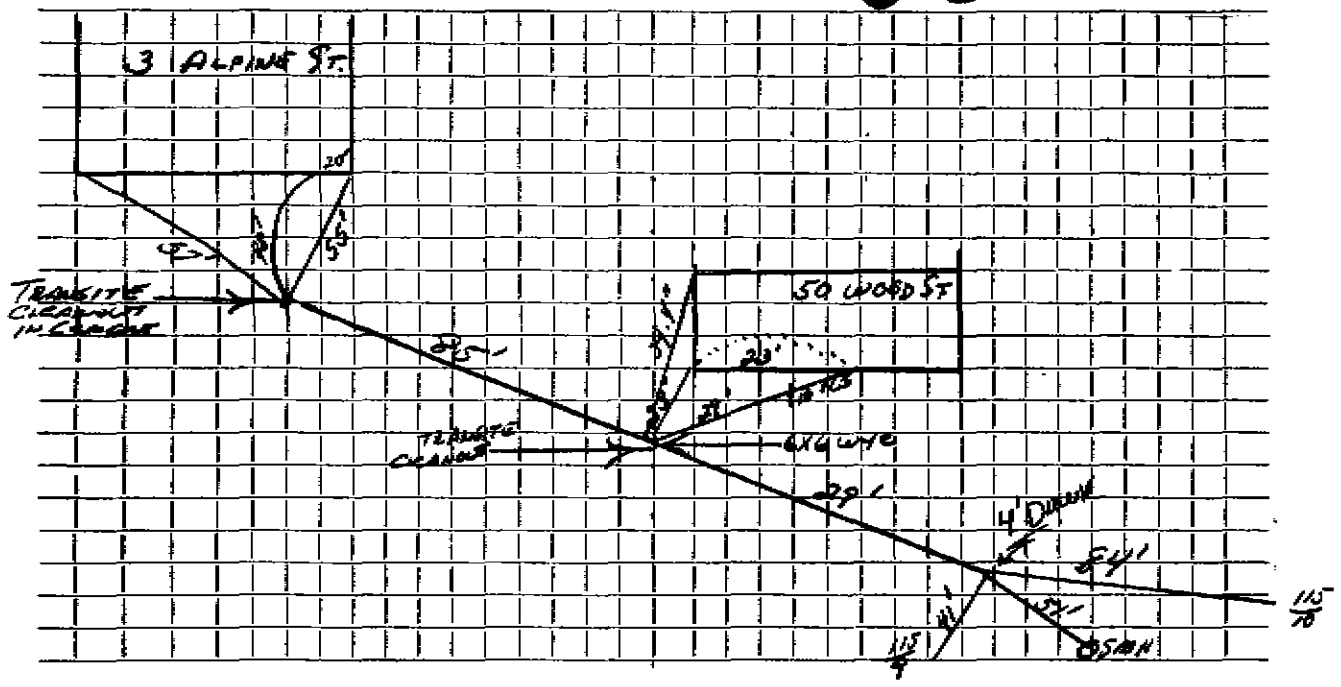

Connection made in ..... Street. Work completed .....

Remarks: .....

.....

....