Name **Service No.**

Address Vacant Lot (M-67, L-28) Wood St. ②

Location

Kind of Pipe PVC **Size** 6" **Size of Main** 8"

Repair—Renewal—New Service **Location**

Date	Material	Amount		Total		Date			Amount	
~~7/13/83~~	~~6 L.F. @ $16.00~~	~~$96.~~	~~00~~							
7/13/83	6 L.F. of 6" PVC	$16.	00	$96.	00					

DATE _____

TOWN OF LEXINGTON — BOARD OF PUBLIC WORKS

SEWER DIVISION

Sketch of Service Here

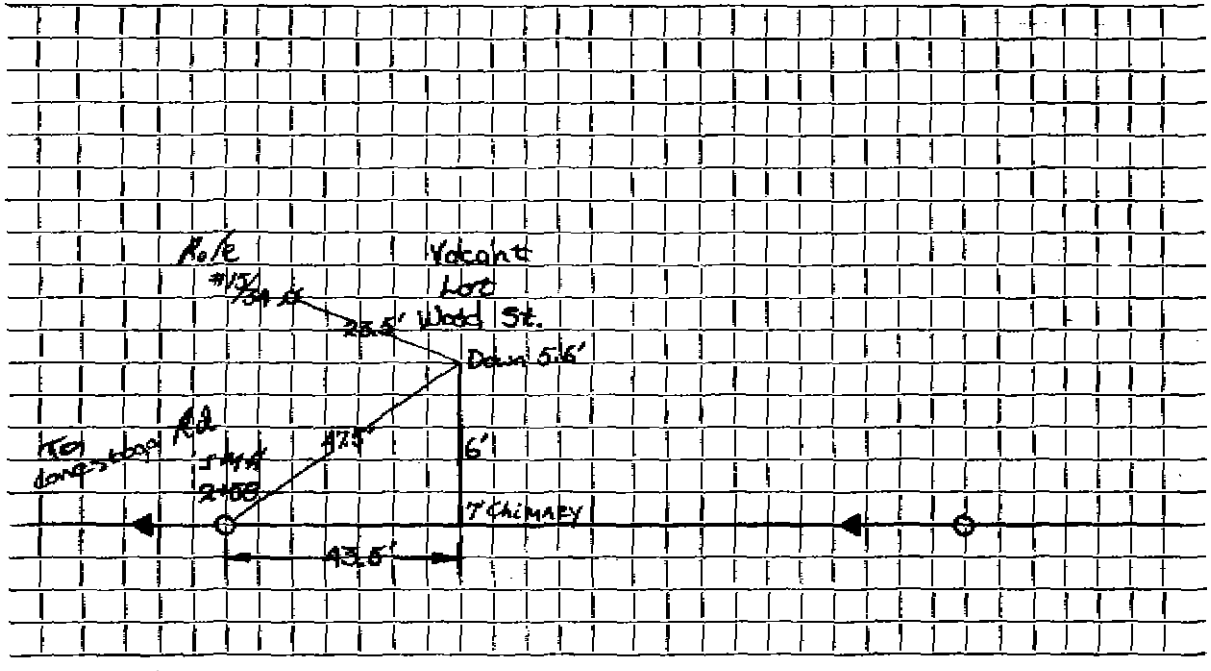

Connection made in ..Wood..... Street. Work completed .....

Remarks: ..M.F.T. Pipe.....