Name | Service No.

Address 11 WOODCLIFFE RD

Location

Kind of Pipe | Size | Size of Main

Repair—Renewal—New Service REDMOND | Location

Date		Material	Amount	Total	Date		Amount
5/18/65	15'	6" A.C. PIPE	$75—				
7/9/98	49'	6" PVC					
	10'	4" PVC					
	1	4X6 FERNCO					
	1	22° BEND					
	1	6" FERNCO					

DATE _____

TOWN OF LEXINGTON — BOARD OF PUBLIC WORKS

SEWER DIVISION

Sketch of Service Here

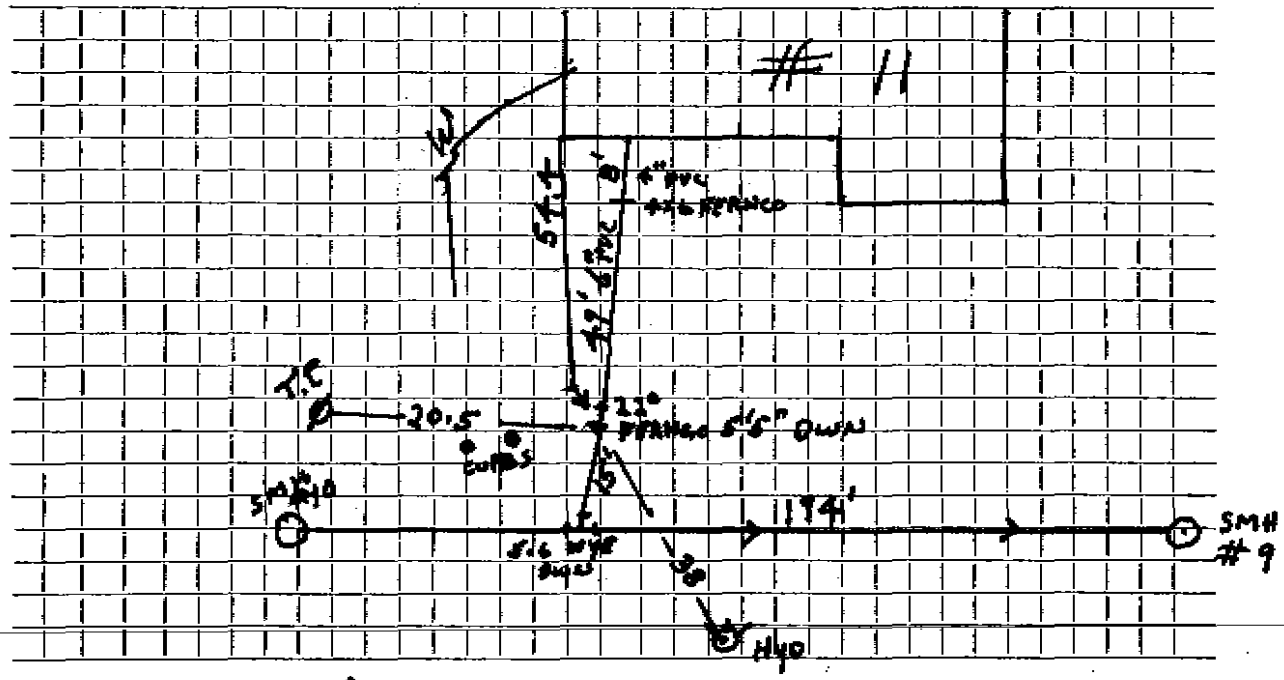

Connection made in WOODCLIFFE RD ..... Street. Work completed .....

Remarks: WATER IN SAME TRENCH AS SEWER AT CURB BOX .....