Name Herbert E. Hurley

Service No. 62

Address 11 Woodland Road

Lexington, Mass.

Location

Kind of Pipe

Size

Size of Main

~~[illegible]~~ New Service

COMMITTED 10-15-51

Location

Date	Material	Amount	Total	Date		Amount
July 1951	Flat Rate		192 00	7-11-51	Deposited	165 00
	INSTALLED BY CONTRACTOR			11-24-51	Posted	27 00
						192 00
	64' -6" sewer pipe @.342 -$21.89					
					bill sent 10-15-51	
	Labor					

HP-7918

TOWN OF LEXINGTON—DEPT. OF PUBLIC WORKS

SEWER DIVISION

DATE ..... NO. .....

The undersigned applies for the construction of a particular sewer connecting No. ..... Street and hereby agrees to comply with the Rules and Regulations governing the construction and use of Particular Sewers, as now or at any future time established by the Board of Selectmen.

Am't of estimate $. . . . . .

Am't Paid $. . . . . .

..... Owner

Sketch of Service Here

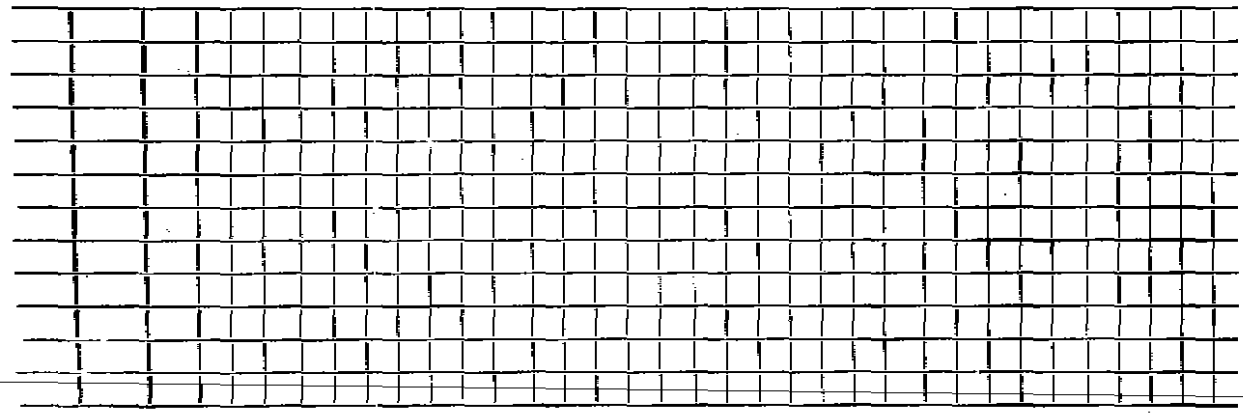

Connection made in ..... Street. Work completed ..... 19..

Remarks: